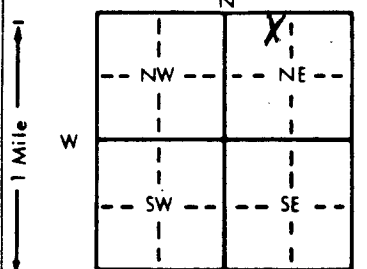


1 LOCATION OF WATER WELL: Fraction **NE 1/4 NW 1/4 NE 1/4** Section Number **35** Township Number **T 1 S S** Range Number **R 15 E EW**  
 County: **Brown**

Distance and direction from nearest town or city street address of well if located within city?

**West edge of Morrill on Roxanna**

2 WATER WELL OWNER: **KDHE-BER**  
 RR#, St. Address, Box # : **Forbes Field, Building 740** Board of Agriculture, Division of Water Resources  
 City, State, ZIP Code : **Topeka, Kansas 66620** Application Number:

3 LOCATE WELL'S LOCATION WITH AN "X" IN SECTION BOX:  
  
 4 DEPTH OF COMPLETED WELL: **88** ft. ELEVATION: .....  
 Depth(s) Groundwater Encountered 1. .... ft. 2. .... ft. 3. **1122.5** ft.  
 WELL'S STATIC WATER LEVEL ..... **26.3** ft. below land surface measured on mo/day/yr ..... **2/28/95** .....  
 Pump test data: Well water was ..... ft. after ..... hours pumping ..... gpm  
 Est. Yield **.NA** gpm: Well water was ..... ft. after ..... hours pumping ..... gpm  
 Bore Hole Diameter: ..... **8** in. to ..... **90** ft., and ..... in. to ..... ft.  
 WELL WATER TO BE USED AS: 5 Public water supply 8 Air conditioning 11 Injection well  
 1 Domestic 3 Feedlot 6 Oil field water supply 9 Dewatering 12 Other (Specify below)  
 2 Irrigation 4 Industrial 7 Lawn and garden only **10** Monitoring well .....  
 Was a chemical/bacteriological sample submitted to Department? Yes.....No.....**X**.....; If yes, mo/day/yr sample was submitted  
 Water Well Disinfected? Yes No **X**

5 TYPE OF BLANK CASING USED:  
 1 Steel 3 RMP (SR) 5 Wrought iron 8 Concrete tile CASING JOINTS: Glued ..... Clamped .....  
**2** PVC 4 ABS 6 Asbestos-Cement 9 Other (specify below) Welded .....  
 7 Fiberglass ..... Threaded ..... **X** .....  
 Blank casing diameter ..... **4** in. to ..... **63** ft., Dia ..... in. to ..... ft., Dia ..... in. to ..... ft.  
 Casing height above land surface ..... **29.3** in., weight ..... lbs./ft. Wall thickness or gauge No. **Sch. 40** .....  
 TYPE OF SCREEN OR PERFORATION MATERIAL:  
 1 Steel 3 Stainless steel 5 Fiberglass **7** PVC 10 Asbestos-cement  
 2 Brass 4 Galvanized steel 6 Concrete tile 8 RMP (SR) 11 Other (specify) .....  
 9 ABS 12 None used (open hole)  
 SCREEN OR PERFORATION OPENINGS ARE:  
 1 Continuous slot **3** Mill slot 5 Gauzed wrapped 8 Saw cut 11 None (open hole)  
 2 Louvered shutter 4 Key punched 6 Wire wrapped 9 Drilled holes  
 7 Torch cut 10 Other (specify) .....  
 SCREEN-PERFORATED INTERVALS: From ..... **63** ft. to ..... **88** ft., From ..... ft. to ..... ft.  
 From ..... ft. to ..... ft., From ..... ft. to ..... ft.  
 GRAVEL PACK INTERVALS: From ..... **60.5** ft. to ..... **90** ft., From ..... ft. to ..... ft.  
 From ..... ft. to ..... ft., From ..... ft. to ..... ft.

6 GROUT MATERIAL: 1 Neat cement **2** Cement grout **3** Bentonite 4 Other .....  
 Grout Intervals: From ..... **0** ft. to ..... **11** ft., From ..... **11** ft. to ..... **60.5** ft., From ..... ft. to ..... ft.  
 What is the nearest source of possible contamination:  
 1 Septic tank 4 Lateral lines 7 Pit privy 10 Livestock pens 14 Abandoned water well  
 2 Sewer lines 5 Cess pool 8 Sewage lagoon 11 Fuel storage 15 Oil well/Gas well  
 3 Watertight sewer lines 6 Seepage pit 9 Feedyard 12 Fertilizer storage **16** Other (specify below) **Grain storage** .....  
 13 Insecticide storage .....  
 Direction from well? **N** How many feet? **700**

FROM	TO	LITHOLOGIC LOG	FROM	TO	PLUGGING INTERVALS
0	3	Clay, Dark Brown			MW1D
3	6	Clay, Medium Brown			GeoCore # 114 Above Ground
6	11	Clay, Medium Red Brown			KDHE # Tag # 117137
11	14	Limestone, Tan to Yellow Brown	84	90	Limestone,
14	19	Shale, Yellow to Tan			
19	22.5	Limestone, Light Gray to Gray Brown to			
22.5	26.5	Shale, Yellow to Green Yellow			
26.5	27.5	Limestone, Light Gray to Gray Brown			
27.5	42	Shale, Green Yellow to Yellow			
42	53	Shale, Light Green to Gray Green			
53	57	Shale, Light Green to Gray Green			
57	68	Shale, Black			
68	73	Shale, Medium Gray to Green Gray to Bl			
73	82	Shale, Medium Gray to Blue Gray			
82	84	Limestone, Tan			

7 CONTRACTOR'S OR LANDOWNER'S CERTIFICATION: This water well was **1** constructed, **2** reconstructed, or **3** plugged under my jurisdiction and was completed on (mo/day/year) ..... **2/28/95** ..... and this record is true to the best of my knowledge and belief. Kansas Water Well Contractor's License No. **527** This Water Well Record was completed on (mo/day/yr) ..... by (signature) **Del R. ...** **3/6/95** under the business name of