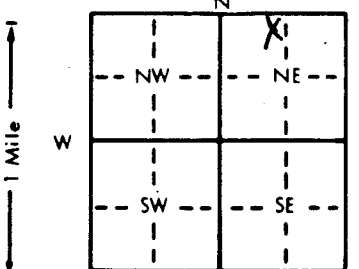


1 LOCATION OF WATER WELL: Fraction NE 1/4 NW 1/4 NE 1/4 Section Number 35 Township Number T 1 S S Range Number R 15 E E/W  
 County: Brown Distance and direction from nearest town or city street address of well if located within city?

West edge of Morrill on Roxanna

2 WATER WELL OWNER: KDHE-BER  
 RR#, St. Address, Box #: Forbes Field, Building 740 Board of Agriculture, Division of Water Resources  
 City, State, ZIP Code: Topeka, Kansas 66620 Application Number:

3 LOCATE WELL'S LOCATION WITH AN "X" IN SECTION BOX:  4 DEPTH OF COMPLETED WELL... 51 ft. ELEVATION: ...  
 Depth(s) Groundwater Encountered 1. ... ft. 2. ... ft. 3. 1122.5 ft.  
 WELL'S STATIC WATER LEVEL ... 23.5 ft. below land surface measured on mo/day/yr ... 2/28/95  
 Pump test data: Well water was ... ft. after ... hours pumping ... gpm  
 Est. Yield .NA. gpm: Well water was ... ft. after ... hours pumping ... gpm  
 Bore Hole Diameter ... 8 in. to ... 56 ft., and ... in. to ... ft.  
 WELL WATER TO BE USED AS: 5 Public water supply 8 Air conditioning 11 Injection well  
 1 Domestic 3 Feedlot 6 Oil field water supply 9 Dewatering 12 Other (Specify below)  
 2 Irrigation 4 Industrial 7 Lawn and garden only 10 Monitoring well  
 Was a chemical/bacteriological sample submitted to Department? Yes.....No.....X.....; If yes, mo/day/yr sample was submitted  
 Water Well Disinfected? Yes No X

5 TYPE OF BLANK CASING USED: 1 Steel 2 PVC 3 RMP (SR) 4 ABS 5 Wrought iron 6 Asbestos-Cement 7 Fiberglass 8 Concrete tile 9 Other (specify below) CASING JOINTS: Glued ... Clamped ... Welded ... Threaded... X ...  
 Blank casing diameter ... 4 in. to ... 11 ft., Dia ... in. to ... ft., Dia ... in. to ... ft.  
 Casing height above land surface ... 29.2 in., weight ... lbs./ft. Wall thickness or gauge No. Sch. 40  
 TYPE OF SCREEN OR PERFORATION MATERIAL: 1 Steel 2 Brass 3 Stainless steel 4 Galvanized steel 5 Fiberglass 6 Concrete tile 7 PVC 8 RMP (SR) 9 ABS 10 Asbestos-cement 11 Other (specify) 12 None used (open hole)  
 SCREEN OR PERFORATION OPENINGS ARE: 1 Continuous slot 2 Louvered shutter 3 Mill slot 4 Key punched 5 Gauzed wrapped 6 Wire wrapped 7 Torch cut 8 Saw cut 9 Drilled holes 11 None (open hole) 10 Other (specify)  
 SCREEN-PERFORATED INTERVALS: From ... 11 ft. to ... 51 ft., From ... ft. to ... ft.  
 GRAVEL PACK INTERVALS: From ... 9 ft. to ... 56 ft., From ... ft. to ... ft.

6 GROUT MATERIAL: 1 Neat cement 2 Cement grout 3 Bentonite 4 Other ...  
 Grout Intervals: From ... 0 ft. to ... 6 ft., From ... 6 ft. to ... 9 ft., From ... ft. to ... ft.  
 What is the nearest source of possible contamination: 1 Septic tank 2 Sewer lines 3 Watertight sewer lines 4 Lateral lines 5 Cess pool 6 Seepage pit 7 Pit privy 8 Sewage lagoon 9 Feedyard 10 Livestock pens 11 Fuel storage 12 Fertilizer storage 13 Insecticide storage 14 Abandoned water well 15 Oil well/Gas well 16 Other (specify below) Grainstorage ...  
 Direction from well? N How many feet? 700

FROM	TO	LITHOLOGIC LOG	FROM	TO	PLUGGING INTERVALS
0	3	Clay, Dark Brown			MW1S
3	6	Clay, Medium Brown			GeoCore # 114 Above Ground
6	11	Clay, Medium Red Brown			KDHE # Tag # 117120
11	14	Limestone, Tan to Yellow Brown			
14	19	Shale, Yellow to Tan			
19	22.5	Limestone, Light Gray to Gray Brown to			
22.5	26.5	Shale, Yellow to Green Yellow			
26.5	27.5	Limestone, Light Gray to Gray Brown			
27.5	42	Shale, Green Yellow to Yellow			
42	53	Shale, Light Green to Gray Green			
53	56	Shale, Light Green to Gray Green			

7 CONTRACTOR'S OR LANDOWNER'S CERTIFICATION: This water well was 1 constructed, 2 reconstructed, or 3 plugged under my jurisdiction and was completed on (mo/day/year) ... 5/27 and this record is true to the best of my knowledge and belief. Kansas Water Well Contractor's License No. ... GeoCore Services, Inc. This Water Well Record was completed on (mo/day/yr) ... 3/8/95 under the business name of ... by (signature) ...

INSTRUCTIONS: Use typewriter or ball point pen. PLEASE PRESS FIRMLY and PRINT clearly. Please fill in blanks, underline or circle the correct answers. Send top three copies to Kansas Department of Health and Environment, Bureau of Water, Topeka, Kansas 66620-0001. Telephone: 913-296-5545. Send one to WATER WELL OWNER and retain one for your records.