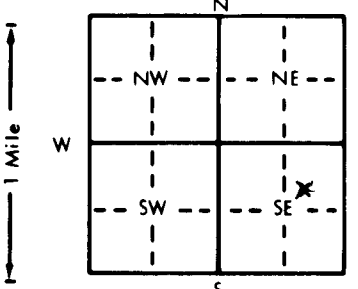


1 LOCATION OF WATER WELL: Fraction SW 1/4 NE 1/4 SE 1/4 Section Number 34 Township Number T 1 S Range Number R 17 E/W

Distance and direction from nearest town or city street address of well if located within city?
3 Miles North two miles east Hiawatha, KS

2 WATER WELL OWNER: Maxine Sass
RR#, St. Address, Box #: 333 W. Kelso St. Board of Agriculture, Division of Water Resources
City, State, ZIP Code: Inglewood, CA 90301 Application Number:

3 LOCATE WELL'S LOCATION WITH AN "X" IN SECTION BOX:  4 DEPTH OF COMPLETED WELL: 56' ft. ELEVATION: ... ft.
Depth(s) Groundwater Encountered 1. 14 ft. 2. ... ft. 3. ... ft.
WELL'S STATIC WATER LEVEL 9 ft. below land surface measured on mo/day/yr 6-21-95
Pump test data: Well water was ... ft. after ... hours pumping ... gpm
Est. Yield ... 12 ... gpm: Well water was ... ft. after ... hours pumping ... gpm
Bore Hole Diameter ... 9 in. to ... 56 ft., and ... in. to ... ft.
WELL WATER TO BE USED AS: 5 Public water supply 8 Air conditioning 11 Injection well
1 Domestic 3 Feedlot 6 Oil field water supply 9 Dewatering 12 Other (Specify below)
2 Irrigation 4 Industrial 7 Lawn and garden only 10 Monitoring well
Was a chemical/bacteriological sample submitted to Department? Yes ... No ; If yes, mo/day/yr sample was submitted
Water Well Disinfected? Yes No

5 TYPE OF BLANK CASING USED: 1 Steel 3 RMP (SR) 5 Wrought iron 8 Concrete tile CASING JOINTS: Glued Clamped ...
2 PVC 4 ABS 6 Asbestos-Cement 9 Other (specify below) Welded ...
7 Fiberglass Threaded ...
Blank casing diameter ... 5 in. to ... 20 ft., Dia ... in. to ... ft., Dia ... in. to ... ft.
Casing height above land surface ... 18 in., weight ... 2.843 lbs./ft. Wall thickness or gauge No. ... SDR 21
TYPE OF SCREEN OR PERFORATION MATERIAL: 7 PVC 10 Asbestos-cement
1 Steel 3 Stainless steel 5 Fiberglass 8 RMP (SR) 11 Other (specify) ...
2 Brass 4 Galvanized steel 6 Concrete tile 9 ABS 12 None used (open hole)
SCREEN OR PERFORATION OPENINGS ARE: 5 Gauzed wrapped 8 Saw cut .020 slot 11 None (open hole)
1 Continuous slot 3 Mill slot 6 Wire wrapped 9 Drilled holes
2 Louvered shutter 4 Key punched 7 Torch cut 10 Other (specify) ...
SCREEN-PERFORATED INTERVALS: From ... 20 ft. to ... 40 ft., From ... ft. to ... ft.
GRAVEL PACK INTERVALS: From ... 19 ft. to ... 56 ft., From ... ft. to ... ft.

6 GROUT MATERIAL: 1 Neat cement 2 Cement grout 3 Bentonite 4 Other ...
Grout Intervals: From ... 0 ft. to ... 19 ft., From ... ft. to ... ft.
What is the nearest source of possible contamination: 10 Livestock pens 14 Abandoned water well
1 Septic tank 4 Lateral lines 7 Pit privy 11 Fuel storage 15 Oil well/Gas well
2 Sewer lines 5 Cess pool 8 Sewage lagoon 12 Fertilizer storage 16 Other (specify below)
3 Watertight sewer lines 6 Seepage pit 9 Feedyard 13 Insecticide storage
Direction from well? How many feet? 20'

FROM	TO	LITHOLOGIC LOG	FROM	TO	PLUGGING INTERVALS
0	6	No Sample			
6	11	Silty Clay-grayish brown			
11	13	sandy clay-yellow brown			
13	14	boulders			
14	19	sand - brn VF-F			
19	24	sand - brn VF-F			
24	33.5	sand - brn VF-F			
33.5	42	shale - gray			
42	44.5	limestone - gray			
44.5	46	shale - dark gray			
46	46.5	limestone - gray			
46.5	56	shale			

7 CONTRACTOR'S OR LANDOWNER'S CERTIFICATION: This water well was (1) constructed, (2) reconstructed, or (3) plugged under my jurisdiction and was completed on (mo/day/year) 6-21-95 and this record is true to the best of my knowledge and belief. Kansas Water Well Contractor's License No. 308 This Water Well Record was completed on (mo/day/yr) 7-4-95 under the business name of Rieschick Drilling Company by (signature) Roy Rieschick

000400