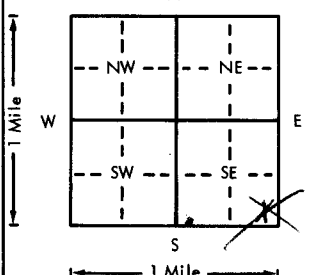
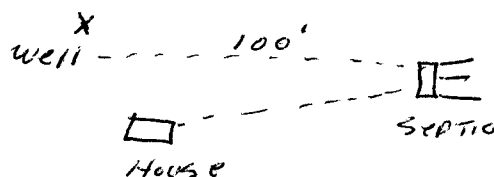


USE TYPEWRITER OR BALL
POINT PEN-PRESS FIRMLY,
PRINT CLEARLY.

WATER WELL RECORD
KSA 82a-1201-1215

Kansas Department of Health and
Environment-Division of Environment
(Water well Contractors)
Topeka, Kansas 66620

SW - SW $\frac{1}{4}$ - SE $\frac{1}{4}$

1. Location of well:		County <u>BROWN</u>	Fraction <u>SE $\frac{1}{4}$ SE $\frac{1}{4}$ SE $\frac{1}{4}$</u>	Section number <u>11</u>	Township number T <u>1</u> S R <u>17</u> <u>EW</u>	Range number
2. Distance and direction from nearest town or city: <u>4 E</u>			3. Owner of well: <u>Don Robidoux - 1218</u>			
Street address of well location if in city: <u>OF Reserve</u>			R.R. or street: City, state, zip code: <u>White Cloud</u>			
4. Locate with "X" in section below:		Sketch map:		6. Bore hole dia. <u>8</u> in. Completion date <u>7-20-76</u>		
				Well depth <u>140</u> ft.		
5. Type and color of material		From	To	7. Cable tool <input checked="" type="checkbox"/> Rotary <input type="checkbox"/> Driven <input type="checkbox"/> Dug <input type="checkbox"/> Hollow rod <input type="checkbox"/> Jetted <input type="checkbox"/> Bored <input type="checkbox"/> Reverse rotary		
<u>TOP SOIL</u>		<u>0</u>	<u>5</u>	8. Use: <input checked="" type="checkbox"/> Domestic <input type="checkbox"/> Public supply <input type="checkbox"/> Industry <input type="checkbox"/> Irrigation <input type="checkbox"/> Air conditioning <input type="checkbox"/> Stock <input type="checkbox"/> Lawn <input type="checkbox"/> Oil field water <input type="checkbox"/> Other		
<u>BROWN CLAY</u>		<u>5</u>	<u>34</u>	9. Casing: Material <u>PVC</u> Height: <u>Above</u> or below Threaded <input type="checkbox"/> Welded <input type="checkbox"/> Surface <u>29</u> in. RMP <u>PVC 90</u> Weight <u>2.58</u> lbs./ft. Dia. <u>5</u> in. to <u>149</u> ft. depth Wall Thickness: inches or Dia. <u>5</u> in. to <u>149</u> ft. depth gage No. <u>2.74</u>		
<u>SHALEY LIME</u>		<u>34</u>	<u>98</u>	10. Screen: Manufacturer's name <u>PUMPCO</u> Type <u>PVC</u> Dia. <u>5</u> Set between <u>80</u> ft. and <u>120</u> ft. Gravel pack? <input checked="" type="checkbox"/> Size range of material <u>0.30x.060</u>		
<u>GREY SANDSTONE</u>		<u>98</u>	<u>110</u>	11. Static water level: <u>90</u> ft. below land surface Date <u>7-19-76</u>		
<u>SHALEY LIME</u>		<u>110</u>	<u>140</u>	12. Pumping level below land surfaces: ____ ft. after ____ hrs. pumping ____ g.p.m. ____ ft. after ____ hrs. pumping ____ g.p.m. Estimated maximum yield <u>7</u> g.p.m.		
				13. Water sample submitted: <u>Yes</u> <input checked="" type="checkbox"/> No <input type="checkbox"/> Date ____		
				14. Well head completion: <u>CAPPED</u> ____ Pitless adapter <u>24</u> inches above grade		
				15. Well grouted? <input checked="" type="checkbox"/> With: <input checked="" type="checkbox"/> Neat cement <input type="checkbox"/> Bentonite <input type="checkbox"/> Concrete Depth: From <u>5</u> ft. to <u>15</u> ft.		
				16. Nearest source of possible contamination: ft. <u>100</u> Direction <u>E</u> Type <u>SEPTIC</u> Well disinfected upon completion? <input checked="" type="checkbox"/> Yes <input type="checkbox"/> No		
				17. Pump: <input checked="" type="checkbox"/> Not installed Manufacturer's name ____ Model number ____ HP ____ Volts ____ Length of drop pipe ____ ft. capacity ____ g.p.m. Type: <input type="checkbox"/> Submersible <input type="checkbox"/> Turbine <input type="checkbox"/> Jet <input type="checkbox"/> Reciprocating <input type="checkbox"/> Centrifugal <input type="checkbox"/> Other		
18. Elevation: <u>909</u>		19. Remarks: <u>OWNER WILL INSTALL SLAB - P.H.S.</u>		20. Water well contractor's certification: This well was drilled under my jurisdiction and this report is true to the best of my knowledge and belief. <u>Stander Dalg Co Inc</u> <u>182</u> Business name License No. ____ Address <u>RT 1 Horton, KS</u> Signed <u>Dale Robidoux</u> Date <u>7-24-76</u> Authorized representative		