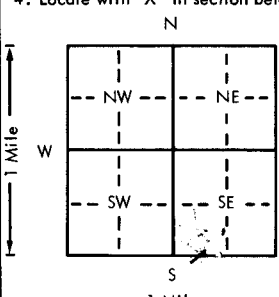
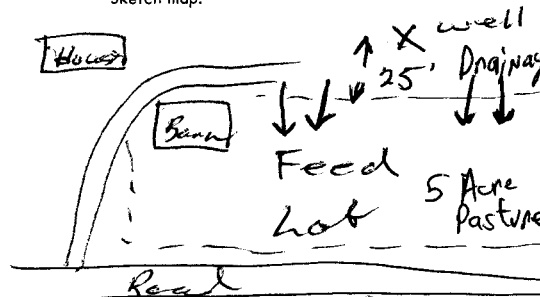


USE TYPEWRITER OR BALL
POINT PEN-PRESS FIRMLY,
PRINT CLEARLY.

WATER WELL RECORD
KSA 82a-1201-1215

Kansas Department of Health and
Environment-Division of Environment
(Water well Contractors)
Topeka, Kansas 66620

1. Location of well:	County	Fraction	Section number	Township number	Range number
	Brown	35 1/4 SW 1/4 SE 1/4	28	T 1 S	R 17 E
2. Distance and direction from nearest town or city: 5 N 1/2 E		3. Owner of well: Virgil John RR #1			
Street address of well location if in city: Hiawatha		City, state, zip code: Hiawatha, KS			
4. Locate with "X" in section below:		Sketch map:		6. Bore hole dia. 12 in. Completion date 7-22-77	
				Well depth 75 ft.	
5. Type and color of material		From	To	7. Cable tool <input checked="" type="checkbox"/> Rotary <input type="checkbox"/> Driven <input type="checkbox"/> Dug	
Top Soil		0	3	<input type="checkbox"/> Hollow rod <input type="checkbox"/> Jetted <input type="checkbox"/> Bored <input type="checkbox"/> Reverse rotary	
Brown Clay		3	13	8. Use: <input checked="" type="checkbox"/> Domestic <input type="checkbox"/> Public supply <input type="checkbox"/> Industry	
Gray Clay		13	18	<input type="checkbox"/> Irrigation <input type="checkbox"/> Air conditioning <input type="checkbox"/> Stock	
Gray White Sandy Clay		18	20	<input type="checkbox"/> Lawn <input type="checkbox"/> Oil field water <input type="checkbox"/> Other	
Br melta coarse Sand		20	29	9. Casing: Material PVC Height: Above or below	
Tan Clay		29	35	Threaded <input type="checkbox"/> Welded <input type="checkbox"/> Surface 24 in.	
Gray Clay		35	73	RMP PVC Blue Weight 2.74 lbs./ft.	
Gray Shale		73	75	Dia. 5 in. to 25 ft. depth Wall Thickness: inches or	
				Dia. in. to ft. depth gage No. 1258	
				10. Screen: Manufacturer's name Pumpco	
				Type PVC Dia. 5"	
				Slot/gauze 20 Length 10	
				Set between 20 ft. and 30 ft.	
				Gravel pack? <input checked="" type="checkbox"/> Size range of material 20/40	
				11. Static water level: mo./day/yr.	
				12 ft. below land surface Date 7-22-77	
				12. Pumping level below land surfaces: Air test	
				ft. after hrs. pumping g.p.m.	
				ft. after hrs. pumping g.p.m.	
				Estimated maximum yield 12 g.p.m.	
				13. Water sample submitted: mo./day/yr.	
				<input checked="" type="checkbox"/> Yes <input checked="" type="checkbox"/> No Date	
				14. Well head completion: Top Cap	
				Pitless adapter 24 Inches above grade	
				15. Well grouted? <input checked="" type="checkbox"/> Yes	
				With: <input checked="" type="checkbox"/> Neat cement <input type="checkbox"/> Bentonite <input type="checkbox"/> Concrete	
				Depth: From 0 ft. to 10 ft.	
				16. Nearest source of possible contamination: Feed Lot	
				ft. 25 Direction S Type Lot	
				Well disinfected upon completion? <input checked="" type="checkbox"/> Yes <input type="checkbox"/> No	
				17. Pump: <input checked="" type="checkbox"/> Not installed	
				Manufacturer's name	
				Model number HP Volts	
				Length of drop pipe ft. capacity g.p.m.	
				Type:	
				<input type="checkbox"/> Submersible <input type="checkbox"/> Turbine	
				<input type="checkbox"/> Jet <input type="checkbox"/> Reciprocating	
				<input type="checkbox"/> Centrifugal <input type="checkbox"/> Other	
18. Elevation: 1051		19. Remarks: Owner will construct cement slab around well		20. Water well contractor's certification:	
Topography: <input checked="" type="checkbox"/> Hill <input checked="" type="checkbox"/> Slope <input type="checkbox"/> Upland <input type="checkbox"/> Valley				This well was drilled under my jurisdiction and this report is true to the best of my knowledge and belief.	
				STRADER Dalg Co Inc 182	
				Business name License No.	
				Address RT 1 Hiawatha, KS	
				Signed Dale Gibson Date 7-25-77	
				Authorized representative	