

WATER WELL RECORD

Form WWC-5


Division of Water Resources App. No.

Empty box for application number

1 LOCATION OF WATER WELL: County: Brown, Fraction: NE 1/4 SE 1/4 SW 1/4 SE 1/4, Section Number: 35, Township No.: T 1 S, Range Number: R 17 E W

Street/Rural Address of Well Location; if unknown, distance & direction from nearest town or intersection: About 1/4 mile West & 1/8 North of 280th and NightHawk Rd. Global Positioning System (GPS) information: Latitude: 39.9154330, Longitude: -95.4761160

2 WATER WELL OWNER: Howard Farms Inc. RR#, Street Address, Box #: 1606 280th St. City, State, ZIP Code: Hiawatha, KS 66434. Collection Method: GPS unit (Garmin 12xl), Est. Accuracy: 3-5 m

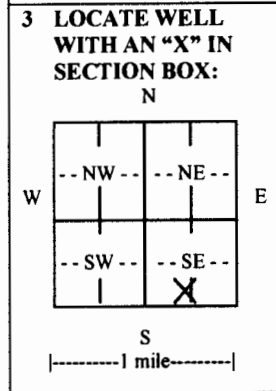

4 DEPTH OF COMPLETED WELL 95 ft. Depth(s) Groundwater Encountered (1)..... ft. (2)..... ft. (3)..... ft. WELL'S STATIC WATER LEVEL 45 ft. below land surface measured on mo/day/yr..... Pump test data: Well water was.....ft. after..... hours pumping..... gpm EST. YIELD.....gpm. Well water was.....ft. after..... hours pumping..... gpm Bore Hole Diameter.....in. to.....ft., and.....in. to.....ft. WELL WATER TO BE USED AS: Irrigation, Domestic, Feedlot, Oil field water supply, Dewatering, Other (Specify below)

5 TYPE OF CASING USED: Steel, PVC, Other. CASING JOINTS: Glued, Clamped, Welded, Threaded. Casing diameter .8 in. to .95 ft., Diameter..... in. to..... ft., Diameter..... in. to..... ft. Casing height above land surface..... in., Weight.....lbs./ft., Wall thickness or gauge No. .... TYPE OF SCREEN OR PERFORATION MATERIAL: Steel, Stainless Steel, PVC, Brass, Galvanized Steel, None used (open hole). SCREEN OR PERFORATION OPENINGS ARE: Continuous slot, Mill slot, Gauze wrapped, Torch cut, Drilled holes, None (open hole), Louvered shutter, Key punched, Wire wrapped, Saw cut, Other (specify)..... SCREEN-PERFORATED INTERVALS: From..... ft. to..... ft., From..... ft. to..... ft., From..... ft. to..... ft. GRAVEL PACK INTERVALS: From..... ft. to..... ft., From..... ft. to..... ft., From..... ft. to..... ft.

6 GROUT MATERIAL: Neat cement, Cement grout, Bentonite, Other. Grout Intervals: From..... ft. to..... ft., From..... ft. to..... ft., From..... ft. to..... ft. What is the nearest source of possible contamination: Septic tank, Lateral lines, Pit privy, Livestock pens, Insecticide storage, Other (specify below), Sewer lines, Cesspool, Sewage lagoon, Fuel storage, Abandoned water well, Watertight sewer lines, Seepage pit, Feedyard, Fertilizer storage, Oil well/gas well, None - Open Field. Direction from well..... Distance from well.....

Table with 5 columns: FROM, TO, LITHOLOGIC LOG, FROM, TO, LITHO. LOG (cont.) or PLUGGING INTERVALS. Data rows show intervals from 0 to 95 feet with lithology: native dirt, hole plug, sand, hole plug, sand.

7 CONTRACTOR'S OR LANDOWNER'S CERTIFICATION: This water well was constructed, reconstructed, or plugged under my jurisdiction and was completed on (mo/day/year) 10/18/2010.... and this record is true to the best of my knowledge and belief. Kansas Water Well Contractor's License No. 779..... This Water Well Record was completed on (mo/day/year) 08/10/2011.... under the business name of Drill-Well, LLC..... by (signature).....

INSTRUCTIONS: Use typewriter or ball point pen. PLEASE PRESS FIRMLY and PRINT clearly. Please fill in blanks and check the correct answers. Send three copies (white, blue, pink) to Kansas Department of Health and Environment, Bureau of Water, Geology Section, 1000 SW Jackson St., Suite 420, Topeka, Kansas 66612-1367. Telephone 785-296-5522. Send one copy to WATER WELL OWNER and retain one for your records. Include fee of \$5.00 for each constructed well. Visit us at http://www.kdheks.gov/waterwell/index.html.