


1 LOCATION OF WATER WELL: Fraction NE 1/4 SE 1/4 SE 1/4 Section Number 18 Township Number T 1 S Range Number R 18 EW
 County: BROWN

Distance and direction from nearest town or city street address of well if located within city?
6 miles east 3/4 South Reserve Kansas

2 WATER WELL OWNER: J.W. Reese
 RR#, St. Address, Box #: RT 1 Board of Agriculture, Division of Water Resources
 City, State, ZIP Code: Reserve KS 66434 Application Number:

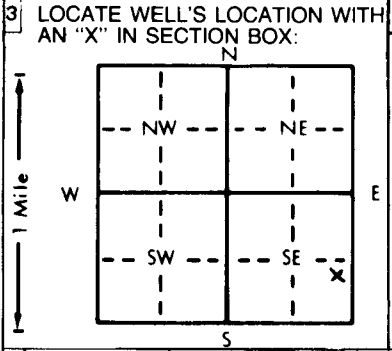

4 DEPTH OF COMPLETED WELL: 7.4 ft. ELEVATION:
 Depth(s) Groundwater Encountered 1. 6.5 ft. 2. ft. 3. ft.
 WELL'S STATIC WATER LEVEL 49.5 ft. below land surface measured on mo/day/yr 6-26-90
 Pump test data: Well water was ft. after hours pumping gpm
 Est. Yield 12 gpm: Well water was ft. after hours pumping gpm
 Bore Hole Diameter 10 in. to ft., and in. to ft.
 WELL WATER TO BE USED AS: 5 Public water supply 8 Air conditioning 11 Injection well
 1 Domestic 3 Feedlot 6 Oil field water supply 9 Dewatering 12 Other (Specify below)
 2 Irrigation 4 Industrial 7 Lawn and garden only 10 Monitoring well
 Was a chemical/bacteriological sample submitted to Department? Yes No If yes, mo/day/yr sample was submitted
 Water Well Disinfected? Yes No

5 TYPE OF BLANK CASING USED: 5 Wrought iron 8 Concrete tile CASING JOINTS: Glued Clamped
 1 Steel 3 RMP (SR) 6 Asbestos-Cement 9 Other (specify below) Welded
 2 PVC 4 ABS 7 Fiberglass Threaded
 Blank casing diameter 5 1/2 in. to 6 1/4 ft., Dia in. to ft., Dia in. to ft.
 Casing height above land surface 1.8 in., weight 2.843 lbs./ft. Wall thickness or gauge No. SPR 21
 TYPE OF SCREEN OR PERFORATION MATERIAL: 7 PVC 10 Asbestos-cement
 1 Steel 3 Stainless steel 5 Fiberglass 8 RMP (SR) 11 Other (specify)
 2 Brass 4 Galvanized steel 6 Concrete tile 9 ABS 12 None used (open hole)
 SCREEN OR PERFORATION OPENINGS ARE: 5 Gauzed wrapped 8 Saw cut 11 None (open hole)
 1 Continuous slot 3 Mill slot 6 Wire wrapped 9 Drilled holes
 2 Louvered shutter 4 Key punched 7 Torch cut 10 Other (specify)
 SCREEN-PERFORATED INTERVALS: From 6.4 ft. to 7.4 ft., From ft. to ft.
 From ft. to ft., From ft. to ft.
 GRAVEL PACK INTERVALS: From 5.0 ft. to 7.4 ft., From ft. to ft.
 From ft. to ft., From ft. to ft.

6 GROUT MATERIAL: 1 Neat cement 2 Cement grout 3 Bentonite 4 Other
 Grout Intervals: From 4 ft. to 20 ft., From ft. to ft., From ft. to ft.
 What is the nearest source of possible contamination:
 1 Septic tank 4 Lateral lines 7 Pit privy 10 Livestock pens 14 Abandoned water well
 2 Sewer lines 5 Cess pool 8 Sewage lagoon 11 Fuel storage 15 Oil well/Gas well
 3 Watertight sewer lines 6 Seepage pit 9 Feedyard 12 Fertilizer storage 16 Other (specify below)
 13 Insecticide storage NONE
 Direction from well? How many feet? KNOWN

FROM	TO	LITHOLOGIC LOG	FROM	TO	PLUGGING INTERVALS
0	4	NS			
4	16	Silt clay BR			
16	35	SANDY clay BR			
35	41.5	SANDY clay h GRAY			
41.5	51	SANDY clay BR			
51	60	SANDY clay GRAY			
60	61.5	SAND & clay GRAY			
61.5	64.5	SANDY clay GRAY			
64.5	71.5	SAND BR U-F = F some med			
71.5	74	Shale GRAY			

7 CONTRACTOR'S OR LANDOWNER'S CERTIFICATION: This water well was (1) constructed (2) reconstructed, or (3) plugged under my jurisdiction and was completed on (mo/day/year) 6-26-90 and this record is true to the best of my knowledge and belief. Kansas Water Well Contractor's License No. 308 This Water Well Record was completed on (mo/day/yr) 6-26-90 under the business name of Rieschick Drilling Co by (signature) Ray Reichel