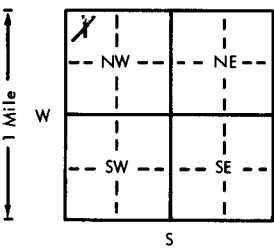
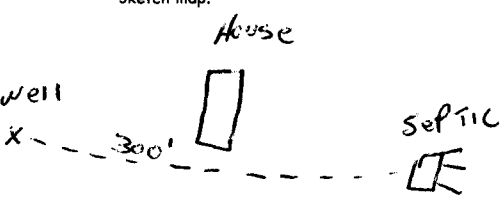


USE TYPEWRITER OR BALL  
POINT PEN-PRESS FIRMLY,  
PRINT CLEARLY.

WATER WELL RECORD  
KSA 82a-1201-1215

BBB

Kansas Department of Health and  
Environment-Division of Environment  
(Water well Contractors)  
Topeka, Kansas 66620

1. Location of well: County <u>Brown</u>		Fraction <u>NW 1/4 NW 1/4 NW 1/4</u>	Section number <u>32</u>	Township number <u>T 1</u>	Range number <u>S 18</u>	<u>EW</u>
2. Distance and direction from nearest town or city: <u>SE 5N</u>			3. Owner of well: <u>ROGER REETZ</u>			
Street address of well location if in city: <u>OF HIAWATHA</u>			R.R. or street: <u>HIAWATHA</u>			
City, state, zip code: <u>HIAWATHA</u>						
4. Locate with "X" in section below:		Sketch map:		6. Bore hole dia. <u>10</u> in. Completion date <u>12-3-76</u>		
				Well depth <u>60</u> ft.		
5. Type and color of material		From	To	7. <input checked="" type="checkbox"/> Cable tool <input checked="" type="checkbox"/> Rotary <input type="checkbox"/> Driven <input type="checkbox"/> Dug		
<u>TOP SOIL</u>		<u>0</u>	<u>4</u>	<input type="checkbox"/> Hollow rod <input type="checkbox"/> Jetted <input type="checkbox"/> Bored <input type="checkbox"/> Reverse rotary		
<u>BROWN Clay</u>		<u>4</u>	<u>30</u>	8. Use: <input checked="" type="checkbox"/> Domestic <input type="checkbox"/> Public supply <input type="checkbox"/> Industry		
<u>Fine sand - coarse sand</u>		<u>30</u>	<u>37</u>	<input type="checkbox"/> Irrigation <input type="checkbox"/> Air conditioning <input type="checkbox"/> Stock		
<u>Blue shale</u>		<u>37</u>	<u>60</u>	<input type="checkbox"/> Lawn <input type="checkbox"/> Oil field water <input type="checkbox"/> Other		
				9. Casing: Material <u>PVC</u> Height: <u>above</u> or below		
				Threaded <input type="checkbox"/> Welded <input type="checkbox"/> Surface <u>24</u> in.		
				RMP <input type="checkbox"/> PVC <u>92</u> Weight <u>258</u> lbs./ft.		
				Dia. <u>5</u> in. to <u>60</u> ft. depth Wall Thickness: inches or		
				Dia. <u>  </u> in. to <u>  </u> ft. depth gage No. <u>274 135</u>		
				10. Screen: Manufacturer's name <u>Pumpco</u>		
				Type <u>PVC</u> Dia. <u>5</u>		
				Slot gauge <u>1020</u> Length <u>20</u>		
				Set between <u>30</u> ft. and <u>50</u> ft.		
				Gravel pack? <input checked="" type="checkbox"/> Size range of material <u>1030/106</u>		
				11. Static water level: <u>33</u> ft. below land surface Date <u>12-3-73</u>		
				12. Pumping level below land surfaces:		
				<u>  </u> ft. after <u>  </u> hrs. pumping <u>  </u> g.p.m.		
				<u>  </u> ft. after <u>  </u> hrs. pumping <u>  </u> g.p.m.		
				Estimated maximum yield <u>7</u> g.p.m.		
				13. Water sample submitted: <u>  </u> mo./day/yr.		
				<input type="checkbox"/> Yes <input checked="" type="checkbox"/> No Date <u>  </u>		
				14. Well head completion: <u>CAP</u>		
				<input type="checkbox"/> Pitless adapter <u>34</u> inches above grade		
				15. Well grouted? <input checked="" type="checkbox"/>		
				With: <input checked="" type="checkbox"/> Neat cement <input type="checkbox"/> Bentonite <input type="checkbox"/> Concrete		
				Depth: From <u>5</u> ft. to <u>15</u> ft.		
				16. Nearest source of possible contamination:		
				ft. <u>300</u> Direction <u>E</u> Type <u>septic</u>		
				Well disinfected upon completion? <input checked="" type="checkbox"/> Yes <input type="checkbox"/> No		
				17. Pump: <input checked="" type="checkbox"/> Not installed		
				Manufacturer's name <u>  </u>		
				Model number <u>  </u> HP <u>  </u> Volts <u>  </u>		
				Length of drop pipe <u>  </u> ft. capacity <u>  </u> g.p.m.		
				Type:		
				<input type="checkbox"/> Submersible <input type="checkbox"/> Turbine		
				<input type="checkbox"/> Jet <input type="checkbox"/> Reciprocating		
				<input type="checkbox"/> Centrifugal <input type="checkbox"/> Other		
18. Elevation: <u>1053</u>		19. Remarks: <u>OWNER WILL INSTAL SLAB</u>		20. Water well contractor's certification:		
Topography: <input checked="" type="checkbox"/> Hill				This well was drilled under my jurisdiction and this report is true to the best of my knowledge and belief.		
<input type="checkbox"/> Slope				<u>Strader Dtg Co Inc</u> <u>182</u>		
<input type="checkbox"/> Upland				Business name <u>  </u> License No. <u>  </u>		
<input type="checkbox"/> Valley				Address <u>RT1 Holton, KS</u>		
				Signed <u>Dale Ashman</u> Date <u>12-4-76</u>		
				Authorized representative		

