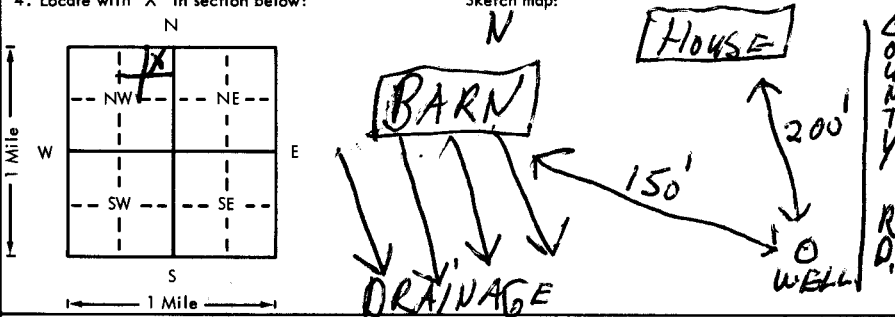


USE TYPEWRITER OR BALL  
POINT PEN-PRESS FIRMLY,  
PRINT CLEARLY.

WATER WELL RECORD  
KSA 82a-1201-1215

BAA

Kansas Department of Health and  
Environment-Division of Environment  
(Water well Contractors)  
Topeka, Kansas 66620

1. Location of well:		County: <b>Brown</b>	Fraction: <b>NE 1/4 NE 1/4 NW 1/4</b>	Section number: <b>35</b>	Township number: <b>T -1 S</b>	Range number: <b>R 18 E</b>
2. Distance and direction from nearest town or city: <b>3 miles east and 8 miles north of Robinson, Kansas</b> Street address of well location if in city:				3. Owner of well: <b>William M. Blanton</b> R.R. or street: <b>RR 2</b> City, state, zip code: <b>Robinson, Kansas 66532</b>		
4. Locate with "X" in section below:		Sketch map:		6. Bore hole dia. <b>34</b> in. Completion date <b>3/3/76</b> Well depth <b>74</b> ft. Bore Hole <b>42"</b> to <b>11'</b>		
				7. <input type="checkbox"/> Cable tool <input type="checkbox"/> Rotary <input type="checkbox"/> Driven <input type="checkbox"/> Dug <input type="checkbox"/> Hollow rod <input type="checkbox"/> Jetted <input checked="" type="checkbox"/> Bored <input type="checkbox"/> Reverse rotary		
5. Type and color of material		From	To	8. Use: <input checked="" type="checkbox"/> Domestic <input type="checkbox"/> Public supply <input type="checkbox"/> Industry <input type="checkbox"/> Irrigation <input type="checkbox"/> Air conditioning <input type="checkbox"/> Stock <input type="checkbox"/> Lawn <input type="checkbox"/> Oil field water <input type="checkbox"/> Other		
Black topsoil		0	3	9. Casing: Material <b>concrete</b> Height: <b>Above</b> or below Threaded <input type="checkbox"/> Welded <input type="checkbox"/> Surface <b>24</b> in. RMP <input type="checkbox"/> PVC <input type="checkbox"/> Weight <b>200</b> lbs./ft. Dia <b>30</b> in. to <b>74</b> ft. depth Wall Thickness: inches or Dia. <input type="checkbox"/> in. to <input type="checkbox"/> ft. depth gage No. <b>2</b> in.		
Light brown windblown soil		3	17	10. Screen: Manufacturer's name _____ Type <b>None</b> Dia. _____ Slot/gauze _____ Length _____ Set between _____ ft. and _____ ft. _____ ft. and _____ ft.		
Dark brown windblown soil		17	31	Gravel pack? _____ Size range of material _____		
Very Fine in texture				11. <del>Static</del> water level: _____ ft. below land surface Date <b>3/4/76</b>		
Brownish sandy soil with some gravel -		31	36	12. Pumping level below land surfaces: <b>62</b> ft. after <b>1 1/2</b> hrs. pumping <b>4</b> g.p.m. _____ ft. after _____ hrs. pumping _____ g.p.m. Estimated maximum yield <b>1 1/2</b> g.p.m.		
produces some water				13. Water sample submitted: _____ mo./day/yr. Yes <input type="checkbox"/> No <input checked="" type="checkbox"/> Date _____		
Hard Yellow Clay		36	44	14. Well head completion: _____ Pitless adapter _____ Inches above grade		
Blue and yellow clay - mixed		44	61	15. Well grouted? <input checked="" type="checkbox"/> With: <input checked="" type="checkbox"/> Neat cement <input type="checkbox"/> Bentonite <input type="checkbox"/> Concrete Depth: From _____ ft. to <b>11</b> ft.		
Hard blue clay - very hard ready to turn to		61	74	16. Nearest source of possible contamination: ft. <b>150</b> Direction <b>NW</b> Type <b>Barn Lot</b> Well disinfected upon completion? <input checked="" type="checkbox"/> Yes <input type="checkbox"/> No		
shale				17. Pump: <input checked="" type="checkbox"/> Not installed Manufacturer's name _____ Model number _____ HP _____ Volts _____ Length of drop pipe _____ ft. capacity _____ g.p.m. Type: <input type="checkbox"/> Submersible <input type="checkbox"/> Turbine <input type="checkbox"/> Jet <input type="checkbox"/> Reciprocating <input type="checkbox"/> Centrifugal <input type="checkbox"/> Other		
(Use a second sheet if needed)						
18. Elevation: <b>1075</b> Topography: <input checked="" type="checkbox"/> Hill <input type="checkbox"/> Slope <input type="checkbox"/> Upland <input type="checkbox"/> Valley	19. Remarks: <b>Concrete slab and vent will be installed by customer. He knows and understands this is a regulation.</b>  <b>William M. Blanton</b>					
				20. Water well contractor's certification: This well was drilled under my jurisdiction and this report is true to the best of my knowledge and belief. <b>POPPELWELL WELL BORING 320</b> Business name _____ License No. _____ Address <b>Amity, MO 64422</b> Signed <b>Jerry Poppe</b> Date <b>3/15/76</b> Authorized representative		

Forward the white, blue and pink copies to the Department of Health and Environment

Form WWC-5

BR < 1001

Σ = 1053