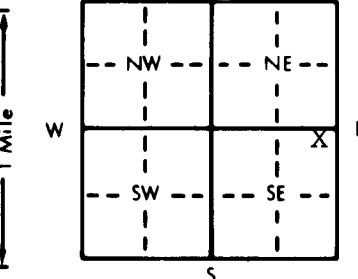


1 LOCATION OF WATER WELL: Fraction NE 1/4 NE 1/4 SE 1/4 Section Number 7 Township Number T 1 S Range Number R 19 EW
 County: DONIPHAN
 Distance and direction from nearest town or city street address of well if located within city?
 1 west, 1/2 north of White Cloud

2 WATER WELL OWNER: Jerry Pfaffly
 RR#, St. Address, Box #: 1116 Berkshire Court Board of Agriculture, Division of Water Resources
 City, State, ZIP Code: Roanake, TX 76262 Application Number:

3 LOCATE WELL'S LOCATION WITH AN "X" IN SECTION BOX:

 4 DEPTH OF COMPLETED WELL: 60 ft. ELEVATION:
 Depth(s) Groundwater Encountered 1. 28' ft. 2. ft. 3. ft.
 WELL'S STATIC WATER LEVEL . 12' ft. below land surface measured on mo/day/yr . 4-28-92
 Pump test data: Well water was . ft. after . hours pumping . gpm
 Est. Yield . 5 . gpm: Well water was . ft. after . hours pumping . gpm
 Bore Hole Diameter . 12" . in. to . ft., and . in. to . ft.
 WELL WATER TO BE USED AS: 5 Public water supply 8 Air conditioning 11 Injection well
 1 Domestic 3 Feedlot 6 Oil field water supply 9 Dewatering 12 Other (Specify below)
 2 Irrigation 4 Industrial 7 Lawn and garden only 10 Monitoring well
 Was a chemical/bacteriological sample submitted to Department? Yes.....No.....X; If yes, mo/day/yr sample was submitted
 Water Well Disinfected? Yes X No

5 TYPE OF BLANK CASING USED: 5 Wrought iron 8 Concrete tile CASING JOINTS: Glued . X . Clamped .
 1 Steel 3 RMP (SR) 6 Asbestos-Cement 9 Other (specify below) Welded .
 2 PVC 4 ABS 7 Fiberglass Threaded .
 Blank casing diameter . 5" . in. to 0-23 . ft., Dia . 5" . in. to 33-59 . ft., Dia . in. to . ft.
 Casing height above land surface . 24" . in., weight . 2.82 . lbs./ft. Wall thickness or gauge No. . 258
 TYPE OF SCREEN OR PERFORATION MATERIAL: 7 PVC 10 Asbestos-cement
 1 Steel 3 Stainless steel 5 Fiberglass 8 RMP (SR) 11 Other (specify) .
 2 Brass 4 Galvanized steel 6 Concrete tile 9 ABS 12 None used (open hole)
 SCREEN OR PERFORATION OPENINGS ARE: 5 Gauzed wrapped 8 Saw cut 11 None (open hole)
 1 Continuous slot 3 Mill slot 6 Wire wrapped 9 Drilled holes
 2 Louvered shutter 4 Key punched 7 Torch cut 10 Other (specify) .
 SCREEN-PERFORATED INTERVALS: From . 23 . ft. to . 33 . ft., From . ft. to . ft.
 From . 59 . ft. to . 60 . ft., From . ft. to . ft.
 GRAVEL PACK INTERVALS: From . 22 . ft. to . 60 . ft., From . ft. to . ft.
 From . ft. to . ft., From . ft. to . ft.

6 GROUT MATERIAL: 1 Neat cement 2 Cement grout 3 Bentonite 4 Other .
 Grout Intervals: From . 0 . ft. to . 22 . ft., From . ft. to . ft., From . ft. to . ft.
 What is the nearest source of possible contamination:
 1 Septic tank 4 Lateral lines 7 Pit privy 10 Livestock pens 14 Abandoned water well
 2 Sewer lines 5 Cess pool 8 Sewage lagoon 11 Fuel storage 15 Oil well/Gas well
 3 Watertight sewer lines 6 Seepage pit 9 Feedyard 12 Fertilizer storage 16 Other (specify below)
 13 Insecticide storage
 Direction from well? west How many feet? 520'

FROM	TO	LITHOLOGIC LOG	FROM	TO	PLUGGING INTERVALS
0	2	Top Soil			
2	22	Clay-Brown-Silty			
22	28	FS-CS-Med-Gravel			
28	32	Clay-Blue			
32-33	58	Shale-Grey			
58	60	Limestone-Grey			

7 CONTRACTOR'S OR LANDOWNER'S CERTIFICATION: This water well was (1) constructed, (2) reconstructed, or (3) plugged under my jurisdiction and was completed on (mo/day/year) . 4-28-92 . and this record is true to the best of my knowledge and belief. Kansas Water Well Contractor's License No. . 182 . This Water Well Record was completed on (mo/day/yr) . 5-9-92 . under the business name of STRADER DRILLING CO., INC. by signature *Dale Skren*