

USE TYPEWRITER OR BALL POINT PEN-PRESS FIRMLY, PRINT CLEARLY.


WATER WELL RECORD
KSA 82a-1201-1215

Kansas Department of Health and Environment-Division of Environment (Water well Contractors) Topeka, Kansas 66620

NE 1/4 SW 1/4 - SW 1/4

1. Location of well: County Doniphan Fraction ~~NW 1/4 SW 1/4~~ Section number 85 Township number T 1 S Range number R 19 E

2. Distance and direction from nearest town or city: 1 N.W. OF Street address of well location if in city: White Cloud 3. Owner of well: ROGER WOLF R.R. or street: City, state, zip code: White Cloud, Ks 66094

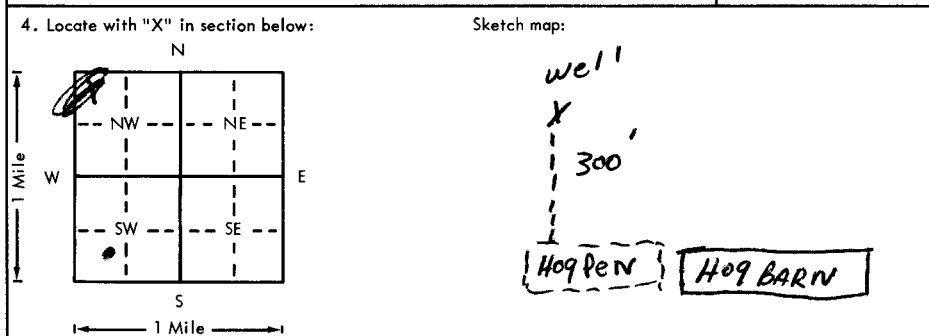

6. Bore hole dia. 12 in. Completion date 9-9-77
Well depth 48 ft.
7. Cable tool Rotary Driven Dug
 Hollow rod Jetted Bored Reverse rotary
8. Use: Domestic Public supply Industry Irrigation Air conditioning Stock Lawn Oil field water Other
9. Casing: Material PVC Height: above or below
Threaded Welded Surface 310 in.
RMP PVC 92 Weight 4.01 lbs./ft.
Dia. 6 in. to 48 ft. depth Wall Thickness: inches or
Dia. in. to ft. depth gage No. 316

5. Type and color of material	From	To
TOP SOIL	0	6
SILTY CLAY	6	31
FINE SAND - COURSE SAND, SILTY	31	33
Blue Clay	33	35
FINE SAND - COURSE SAND, SILTY, GRAVEL	35	38
Shaley, Limestone	38	48
high iron		

10. Screen: Manufacturer's name Pumpco MPI
Type PVC Dia. 5
 gauze .020 Length 10
Set between 30 ft. and 40 ft.
Gravel pack? Size range of material .030 x .060
11. Static water level: 28 ft. below land surface Date 9-9-77 mo./day/yr.
12. Pumping level below land surfaces:
 ft. after hrs. pumping g.p.m.
 ft. after hrs. pumping g.p.m.
Estimated maximum yield 15 g.p.m.
13. Water sample submitted: mo./day/yr.
 Yes No Date
14. Well head completion: CAP
 Pitless adapter 36 inches above grade
15. Well grouted?
With: Neat cement Bentonite Concrete
Depth: From 5 ft. to 15 ft.
16. Nearest source of possible contamination: 300 ft. Direction S Type LOTS
Well disinfected upon completion? Yes No
17. Pump: Not installed
Manufacturer's name
Model number HP Volts
Length of drop pipe ft. capacity g.p.m.
Type:
 Submersible Turbine
 Jet Reciprocating
 Centrifugal Other

18. Elevation: 850
Topography: Hill Slope Upland Valley
19. Remarks: OWNER TO INSTAL SLAB

20. Water well contractor's certification:
This well was drilled under my jurisdiction and this report is true to the best of my knowledge and belief.
Business name STADER DAIG Co Inc License No. 182
Address HALTON KANS
Signed Dale Ashman Date 9-13-77
Authorized representative

BR = 812 0 = 822

40
 T 1 S
 R 19 E
 Sec 8
 NW 1/4 SW 1/4