

USE TYPEWRITER OR BALL POINT PEN—PRESS FIRMLY, PRINT CLEARLY.


WATER WELL RECORD  
KSA 82a-1201-1215

Kansas Department of Health and Environment—Division of Environment  
(Water well Contractors)  
Topeka, Kansas 66620

CCD 5

1. Location of well: County **DONIPHAN** Fraction **NW 1/4 NW 1/4 NW 1/4** Section number **8** Township number **T 1 S R** Range number **19** (E/W)

2. Distance and direction from nearest town or city: **1 1/2 miles north of White Cloud, Kansas**  
Street address of well location if in city:  
3. Owner of well: **White Cloud Grain Co.**  
R.R. or street: **White Cloud, Kansas**  
City, state, zip code:

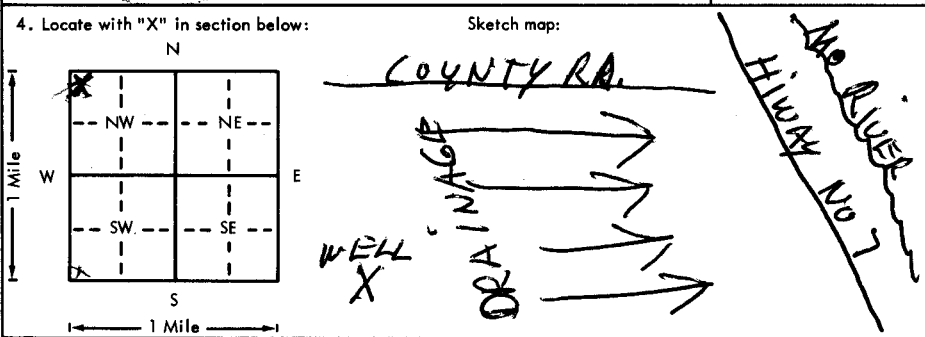

6. Bore hole dia. **34** in. Completion date **2/16/77**  
Well depth **33** ft. Bore hole is **42** "to l"  
7.  Cable tool  Rotary  Driven  Dug  
 Hollow rod  Jetted  Bored  Reverse rotary  
8. Use:  Domestic  Public supply  Industry  
 Irrigation  Air conditioning  Stock  
 Lawn  Oil field water  Other  
9. Casing: Material **concrete** Above or below  
Threaded  Welded  Surface **26** in./ft.  
RMP  PVC  Weight **200** lbs./ft.  
Dia. **30** in. to **33** ft. depth Wall Thickness: inches or  
Dia.  in. to  ft. depth gage No. **2** in.

5. Type and color of material	From	To
Black topsoil - very hard and dry	0	2 1/2
Light yellow windblown	2 1/2	6
Same w/black streaks	6	14
Same, somewhat darker in color - very soft	14	21
Coarse to very coarse	21	25
Brown sand and gravel - very productive		
Very hard blue gray shale	25	33
Limestone	33	
(Use a second sheet if needed)		

10. Screen: Manufacturer's name \_\_\_\_\_  
Type \_\_\_\_\_ Dia. \_\_\_\_\_  
Slot/gauze \_\_\_\_\_ Length \_\_\_\_\_  
Set between \_\_\_\_\_ ft. and \_\_\_\_\_ ft.  
\_\_\_\_\_ ft. and \_\_\_\_\_ ft.  
Gravel pack? \_\_\_\_\_ Size range of material \_\_\_\_\_  
11. Static water level: \_\_\_\_\_ mo./day/yr.  
**14** ft. below land surface Date **2/15/77**  
12. Pumping level below land surfaces:  
**18** ft. after **1 1/2** hrs. pumping **40** g.p.m.  
**24** ft. after **3** hrs. pumping **40** g.p.m.  
Estimated maximum yield **13** g.p.m.  
13. Water sample submitted: \_\_\_\_\_ mo./day/yr.  
 Yes  No Date \_\_\_\_\_  
14. Well head completion:  
 Pitless adapter \_\_\_\_\_ Inches above grade  
15. Well grouted?   
With  Neat cement  Bentonite  Concrete  
Depth: From **0** ft. to **11** ft.  
16. Nearest source of possible contamination:  
ft. **4,000** Direction **E** Type **MO. River**  
Well disinfected upon completion?  Yes  No  
17. Pump:  Not installed  
Manufacturer's name \_\_\_\_\_  
Model number \_\_\_\_\_ HP \_\_\_\_\_ Volts \_\_\_\_\_  
Length of drop pipe \_\_\_\_\_ ft. capacity \_\_\_\_\_ g.p.m.  
Type:  
 Submersible  Turbine  
 Jet  Reciprocating  
 Centrifugal  Other

18. Elevation: **990**  
Topography:  Hill  Slope  Upland  Valley  
19. Remarks: **Concrete slab and vent will be installed by customer, they know and understand this is a regulation in Co. of**  
**Roger D. Wolfe, President**

20. Water well contractor's certification:  
This well was drilled under my jurisdiction and this report is true to the best of my knowledge and belief.  
**POPPELWELL WELL BORING 320**  
Business name **Amity, MO** License No. **64422**  
Address \_\_\_\_\_  
Signed **Jerry Poppe** Date **3/7/77**  
Authorized representative

T-1  
R-1290  
W-0  
Sec-85  
NEW MEASUREMENT