

USE TYPEWRITER OR BALL POINT PEN-PRESS FIRMLY, PRINT CLEARLY.


WATER WELL RECORD
KSA 82a-1201-1215

Kansas Department of Health and Environment-Division of Environment
(Water well Contractors)
Topeka, Kansas 66620

SE
NE 1/4 SW 1/4 SW 1/4

1. Location of well: County Doniphan Fraction SW 1/4 SW 1/4 NE 1/4 Section number 85 Township number T 1 S R 19 E W Range number

2. Distance and direction from nearest town or city: 1 mi. N.W. 3. Owner of well: White Cloud Grain Co.
Street address of well location if in city: White Cloud R.R. or street: R.R.
City, state, zip code: White Cloud

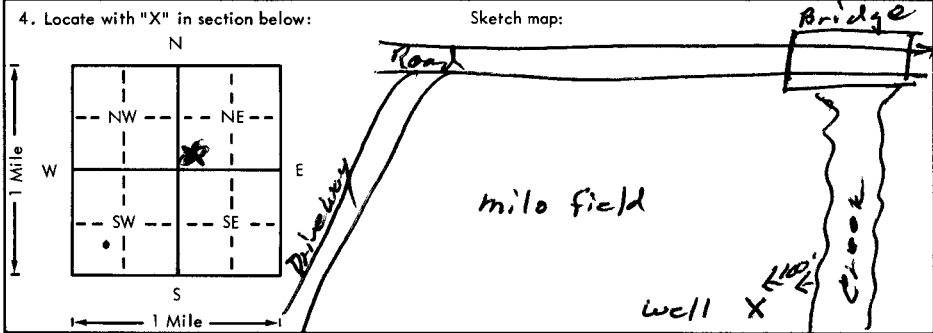

6. Bore hole dia. 1 1/2 in. Completion date 5-10-78
Well depth 50 ft.
7. Cable tool Rotary Driven Dug
 Hollow rod Jetted Bored Reverse rotary
8. Use: Domestic Public supply Industry
 Irrigation Air conditioning Stock
 Lawn Oil field water Other
9. Casing: Material PVC Height Above or below
Threaded Welded Surface 24 in.
RMP PV glue Weight 403 lbs./ft.
Dia. 6 in. to 50 ft. depth Wall Thickness: inches or
Dia. in. to ft. depth gage No. 316

5. Type and color of material	From	To
<u>Black Silt</u>	<u>0</u>	<u>6</u>
<u>Brown Clay</u>	<u>6</u>	<u>7</u>
<u>Black Silty Clay</u>	<u>7</u>	<u>14</u>
<u>Brown Silty Clay</u>	<u>14</u>	<u>22</u>
<u>Blue Clay Sandy & Gravelly</u>	<u>22</u>	<u>30</u>
<u>Gray Limestone</u>	<u>30</u>	<u>32</u>
<u>Black Shale</u>	<u>32</u>	<u>35</u>
<u>Gray Shale</u>	<u>35</u>	<u>50</u>

10. Screen: Manufacturer's name Pumped
Type PVC Dia. 7 1/2 6"
Slot/gauze 0.020 Length 10'
Set between 22 ft. and 32 ft.
Gravel pack? Size range of material 10/30/60
11. Static water level: 20 ft. below land surface Date 5-10-78
12. Pumping level below land surfaces: Air test
 ft. after hrs. pumping g.p.m.
 ft. after hrs. pumping g.p.m.
Estimated maximum yield 8 g.p.m.
13. Water sample submitted: mo./day/yr.
 Yes No Date
14. Well head completion: Top Cap
 Pitless adapter 24 Inches above grade
15. Well grouted? YES
With: Neat cement Bentonite Concrete
Depth: From 5 ft. to 15 ft.
16. Nearest source of possible contamination:
ft. 100 Direction East Type Creek
Well disinfected upon completion? Yes No
17. Pump: Not installed
Manufacturer's name
Model number HP Volts
Length of drop pipe ft. capacity g.p.m.
Type:
 Submersible Turbine
 Jet Reciprocating
 Centrifugal Other

18. Elevation: 850
Topography:
 Hill
 Slope
 Upland
 Valley

19. Remarks:
owner to install slab

20. Water well contractor's certification:
This well was drilled under my jurisdiction and this report is true to the best of my knowledge and belief.
Business name STRADER D&G Co Inc License No. 182
Address RT1, Holton, KS
Signed Dale Ashburn Date 5-11-78
Authorized representative

Forward the white, blue and pink copies to the Department of Health and Environment

Form WWC-5

BR = 820 ? = 830

chg 20
 T 1 S R 19 E W
 Sec 8
 SW 1/4 NE 1/4