


1 LOCATION OF WATER WELL: Fraction SW 1/4 NW 1/4 NE 1/4 Section Number 15 Township Number T 1 S Range Number R 19 E/W  
 County: Douphan

Distance and direction from nearest town or city street address of well if located within city?  
1 mile east White Cloud, Ks

2 WATER WELL OWNER: John Taylor  
 RR#, St. Address, Box #: Box 67 Board of Agriculture, Division of Water Resources  
 City, State, ZIP Code: White Cloud Ks 66094 Application Number:

3 LOCATE WELL'S LOCATION WITH AN "X" IN SECTION BOX:

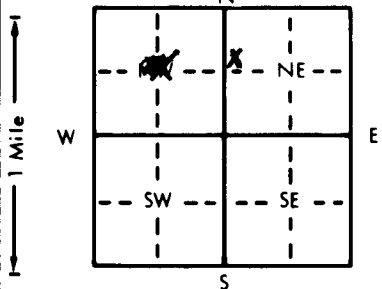

4 DEPTH OF COMPLETED WELL: 43 ft. ELEVATION: .....

Depth(s) Groundwater Encountered 1. 33.5 ft. 2. .... ft. 3. .... ft.  
 WELL'S STATIC WATER LEVEL: +2 ft. below land surface measured on mo/day/yr 9-17-85  
 Pump test data: Well water was 1.4 ft. after 1 hours pumping 45 gpm  
 Est. Yield 100 gpm: Well water was ..... ft. after ..... hours pumping ..... gpm  
 Bore Hole Diameter: 8 in. to 4.3 ft., and ..... in. to ..... ft.  
 WELL WATER TO BE USED AS:  
 1 Domestic  Feedlot 6 Oil field water supply 9 Dewatering 12 Other (Specify below)  
 2 Irrigation 4 Industrial 7 Lawn and garden only 10 Observation well  
 Was a chemical/bacteriological sample submitted to Department? Yes.....No ; If yes, mo/day/yr sample was submitted  
 Water Well Disinfected? Yes  No

5 TYPE OF BLANK CASING USED:  
 1 Steel 3 RMP (SR) 5 Wrought iron 8 Concrete tile CASING JOINTS: Glued ..... Clamped .....  
 PVC 4 ABS 6 Asbestos-Cement 9 Other (specify below) Welded .....  
 7 Fiberglass ..... Threaded.....

Blank casing diameter: 5 in. to 3.3 ft., Dia. .... in. to ..... ft., Dia. .... in. to ..... ft.  
 Casing height above land surface: 24 in., weight 2.873 lbs./ft. Wall thickness or gauge No. 0.265

TYPE OF SCREEN OR PERFORATION MATERIAL:  
 PVC 10 Asbestos-cement  
 1 Steel 3 Stainless steel 5 Fiberglass 8 RMP (SR) 11 Other (specify) .....  
 2 Brass 4 Galvanized steel 6 Concrete tile 9 ABS 12 None used (open hole)

SCREEN OR PERFORATION OPENINGS ARE:  
 Continuous slot 3 Mill slot 5 Gauzed wrapped 8 Saw cut 11 None (open hole)  
 2 Louvered shutter 4 Key punched 6 Wire wrapped 9 Drilled holes  
 7 Torch cut 10 Other (specify) .....

SCREEN-PERFORATED INTERVALS: From 3.3 ft. to 4.3 ft., From ..... ft. to ..... ft.  
 From ..... ft. to ..... ft., From ..... ft. to ..... ft.  
 GRAVEL PACK INTERVALS: From 2.5 ft. to 4.3 ft., From ..... ft. to ..... ft.  
 From ..... ft. to ..... ft., From ..... ft. to ..... ft.

6 GROUT MATERIAL:  Neat cement 2 Cement grout 3 Bentonite 4 Other .....

Grout Intervals: From 7 ft. to 19 ft., From ..... ft. to ..... ft., From ..... ft. to ..... ft.  
 What is the nearest source of possible contamination:  
 Livestock pens 14 Abandoned water well  
 1 Septic tank 4 Lateral lines 7 Pit privy 11 Fuel storage 15 Oil well/Gas well  
 2 Sewer lines 5 Cess pool 8 Sewage lagoon 12 Fertilizer storage 16 Other (specify below)  
 3 Watertight sewer lines 6 Seepage pit 9 Feedyard 13 Insecticide storage

Direction from well? How many feet? 150

FROM	TO	LITHOLOGIC LOG	FROM	TO	LITHOLOGIC LOG
0	17	silty clay Br			
17	29	silt & clay gray			
29	33.5	clay & Br.			
33.5	43	sand & gravel Br			

7 CONTRACTOR'S OR LANDOWNER'S CERTIFICATION: This water well was (1) constructed, (2) reconstructed, or (3) plugged under my jurisdiction and was completed on (mo/day/year) 9-17-85 and this record is true to the best of my knowledge and belief. Kansas Water Well Contractor's License No. 308 This Water Well Record was completed on (mo/day/yr) 9-25-85 under the business name of Bioschick Drilling Co by (signature) Ray Benschel

INSTRUCTIONS: Use typewriter or ball point pen, PLEASE PRESS FIRMLY and PRINT clearly. Please fill in blanks, underline or circle the correct answers. Send top three copies to Kansas Department of Health and Environment, Division of Environment, Environmental Geology Section, Topeka, KS 66620. Send one to WATER WELL OWNER and retain one for your records.