


1 LOCATION OF WATER WELL: Fraction SW 1/4 NW 1/4 NE 1/4 Section Number 15 Township Number T 1 S Range Number R 19 EW  
 County: Doniphan

Distance and direction from nearest town or city street address of well if located within city?  
1 mile east white cloud ks

2 WATER WELL OWNER: Taylor Farms  
 RR#, St. Address, Box #: Box 67  
 City, State, ZIP Code: White Cloud, KS 66094  
 Board of Agriculture, Division of Water Resources  
 Application Number:

3 LOCATE WELL'S LOCATION WITH AN "X" IN SECTION BOX:

4 DEPTH OF COMPLETED WELL: 45 ft. ELEVATION:  
 Depth(s) Groundwater Encountered 1. 29 ft. 2. ft. 3. ft.  
 WELL'S STATIC WATER LEVEL + 4 ft. below land surface measured on mo/day/yr 11-23-90  
 Pump test data: Well water was ft. after hours pumping gpm  
 Est. Yield 200 gpm: Well water was ft. after hours pumping gpm  
 Bore Hole Diameter 12 1/4 in. to 4 1/2 in. to in. to ft.

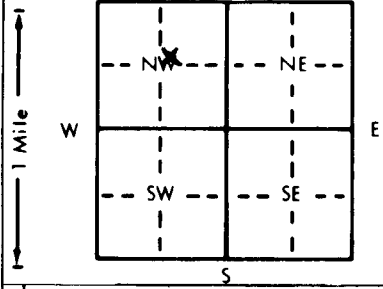

WELL WATER TO BE USED AS:  
 1 Domestic  3 Feedlot  6 Oil field water supply  9 Dewatering  12 Other (Specify below)  
 2 Irrigation  4 Industrial  7 Lawn and garden only  10 Monitoring well  
 Was a chemical/bacteriological sample submitted to Department? Yes.....No .....; If yes, mo/day/yr sample was submitted  
 Water Well Disinfected? Yes  No

5 TYPE OF BLANK CASING USED:  
 1 Steel  3 RMP (SR)  5 Wrought iron  8 Concrete tile  CASING JOINTS: Glued  Clamped.....  
 2 PVC  4 ABS  6 Asbestos-Cement  9 Other (specify below) Welded.....  
 7 Fiberglass  Threaded.....

Blank casing diameter 8" in. to 35 ft., Dia. in. to ft., Dia. in. to ft.  
 Casing height above land surface 24 in., weight lbs./ft. Wall thickness or gauge No.

TYPE OF SCREEN OR PERFORATION MATERIAL:  
 1 Steel  3 Stainless steel  5 Fiberglass  8 RMP (SR)  10 Asbestos-cement   
 2 Brass  4 Galvanized steel  6 Concrete tile  9 ABS  11 Other (specify).....  
 7 PVC  12 None used (open hole)

SCREEN OR PERFORATION OPENINGS ARE:  
 1 Continuous slot  3 Mill slot  5 Gauzed wrapped  11 None (open hole)  
 2 Louvered shutter  4 Key punched  6 Wire wrapped  9 Drilled holes  
 7 Torch cut  10 Other (specify).....

SCREEN-PERFORATED INTERVALS: From 35 ft. to 45 ft., From ft. to ft.  
 From ft. to ft., From ft. to ft.  
 GRAVEL PACK INTERVALS: From 32 ft. to 45 ft., From ft. to ft.  
 From ft. to ft., From ft. to ft.

6 GROUT MATERIAL:  1 Neat cement  2 Cement grout  3 Bentonite  4 Other.....  
 Grout Intervals: From 7 ft. to 32 ft., From ft. to ft., From ft. to ft.

What is the nearest source of possible contamination:  
 1 Septic tank  4 Lateral lines  7 Pit privy  10 Livestock pens  14 Abandoned water well   
 2 Sewer lines  5 Cess pool  8 Sewage lagoon  11 Fuel storage  15 Oil well/Gas well   
 3 Watertight sewer lines  6 Seepage pit  9 Feedyard  12 Fertilizer storage  16 Other (specify below) None known

Direction from well? How many feet?

FROM	TO	LITHOLOGIC LOG	FROM	TO	PLUGGING INTERVALS
0	4	silt			
4	29	silt & clay BR			
29	32	SAND GRAY VEE			
32	43	SAND BR VA - COARSE some gravel			
43	45	Shale gray			

7 CONTRACTOR'S OR LANDOWNER'S CERTIFICATION: This water well was  (1) constructed, (2) reconstructed, or (3) plugged under my jurisdiction and was completed on (mo/day/year) 11-23-90 and this record is true to the best of my knowledge and belief. Kansas Water Well Contractor's License No. 308 This Water Well Record was completed on (mo/day/yr) 11-23-90 under the business name of Buschel Drilling Co by (signature) Ray Buschel