


1 LOCATION OF WATER WELL: County: Doniphan Fraction: SW 1/4 NW 1/4 NW 1/4 Section Number: 25 Township Number: T 1 S Range Number: R 19 EW

Distance and direction from nearest town or city street address of well if located within city?

3 mi South E White Cloud, KS

2 WATER WELL OWNER: John Taylor Board of Agriculture, Division of Water Resources
 RR#, St. Address, Box #: White Cloud, KS 66094 Application Number:
 City, State, ZIP Code:

3 LOCATE WELL'S LOCATION WITH AN "X" IN SECTION BOX:

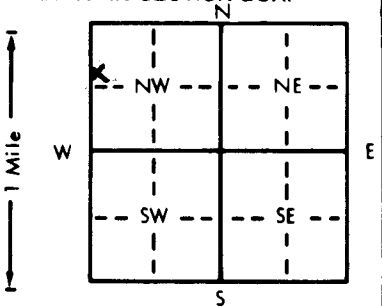

4 DEPTH OF COMPLETED WELL: 62' ft. ELEVATION: ft.
 Depth(s) Groundwater Encountered 1. 4.8 ft. 2. ft. 3. ft.
 WELL'S STATIC WATER LEVEL: 17' 6" ft. below land surface measured on mo/day/yr 11-17-83
 Pump test data: Well water was ft. after hours pumping gpm
 Est. Yield 1.8 gpm: Well water was ft. after hours pumping gpm
 Bore Hole Diameter: 8 in. to 6.2' ft., and in. to ft.
 WELL WATER TO BE USED AS:
 1 Domestic 3 Feedlot 6 Oil field water supply 9 Dewatering 12 Other (Specify below)
 2 Irrigation 4 Industrial 7 Lawn and garden only 10 Observation well
 Was a chemical/bacteriological sample submitted to Department? Yes.....No X.....; If yes, mo/day/yr sample was submitted
 Water Well Disinfected? Yes X No

5 TYPE OF BLANK CASING USED:
 1 Steel 3 RMP (SR) 6 Asbestos-Cement 9 Other (specify below) CASING JOINTS: Glued X Clamped
 2 PVC 4 ABS 7 Fiberglass Welded
 Blank casing diameter: 5 in. to 4.8 ft., Dia in. to ft., Dia in. to ft.
 Casing height above land surface: 1.8 in., weight 2.873 lbs./ft. Wall thickness or gauge No. 0.065
 TYPE OF SCREEN OR PERFORATION MATERIAL:
 7 PVC 10 Asbestos-cement
 1 Steel 3 Stainless steel 5 Fiberglass 8 RMP (SR) 11 Other (specify)
 2 Brass 4 Galvanized steel 6 Concrete tile 9 ABS 12 None used (open hole)
 SCREEN OR PERFORATION OPENINGS ARE:
 1 Continuous slot 3 Mill slot 5 Gauzed wrapped 8 Saw cut 11 None (open hole)
 2 Louvered shutter 4 Key punched 6 Wire wrapped 9 Drilled holes
 7 Torch cut 10 Other (specify)
 SCREEN-PERFORATED INTERVALS: From 4.8 ft. to 6.2 ft., From ft. to ft.
 From 5 ft. to ft., From ft. to ft.
 GRAVEL PACK INTERVALS: From 1.6 ft. to 6.2 ft., From ft. to ft.
 From ft. to ft., From ft. to ft.

6 GROUT MATERIAL: 1 Neat cement 2 Cement grout 3 Bentonite 4 Other
 Grout Intervals: From 5 ft. to 1.6 ft., From ft. to ft., From ft. to ft.
 What is the nearest source of possible contamination:
 1 Septic tank 4 Lateral lines 7 Pit privy 10 Livestock pens 14 Abandoned water well
 2 Sewer lines 5 Cess pool 8 Sewage lagoon 11 Fuel storage 15 Oil well/Gas well
 3 Watertight sewer lines 6 Seepage pit 9 Feedyard 12 Fertilizer storage 16 Other (specify below)
 13 Insecticide storage
 Direction from well? How many feet?

FROM	TO	LITHOLOGIC LOG	FROM	TO	LITHOLOGIC LOG
0	4' 0"	AS			
4	10.5	Silt clay Br.			
10.5	22	Silt clay GRAY			
22	37	Silt clay GRAY			
37	42	Silt clay GRAY some sand			
42	49	Silt clay GRAY some sand			
49	51.5	Sandy GR. GRAY			
51.5	54	Silt clay GRAY			
54	62	Shale GRAY			

7 CONTRACTOR'S OR LANDOWNER'S CERTIFICATION: This water well was (1) constructed, (2) reconstructed, or (3) plugged under my jurisdiction and was completed on (mo/day/year) 11-17-83 and this record is true to the best of my knowledge and belief. Kansas Water Well Contractor's License No. 308 This Water Well Record was completed on (mo/day/yr) 11-18-83 under the business name of Bieschick Drilling by (signature) Ray Bieschick

INSTRUCTIONS: Use typewriter or ball point pen, PLEASE PRESS FIRMLY and PRINT clearly. Please fill in blanks, underline or circle the correct answers. Send top three copies to Kansas Department of Health and Environment, Division of Environment, Environmental Geology Section, Topeka, KS 66620. Send one to WATER WELL OWNER and retain one for your records.