

USE TYPEWRITER OR BALL POINT PEN-PRESS FIRMLY, PRINT CLEARLY.


WATER WELL RECORD
KSA 82a-1201-1215

Kansas Department of Health and Environment-Division of Environment (Water well Contractors) Topeka, Kansas 66620

SE 1/4 - SW 1/4 - NE 1/4 34 1

1. Location of well:	County DEMPHIAN	Fraction NE 1/4 NE 1/4 NE 1/4	Section number 3	Township number T 2 S	Range number R 19 E/W
----------------------	---------------------------	---	----------------------------	---------------------------------	---------------------------------

2. Distance and direction from nearest town or city: 4 N	3. Owner of well: PRESTON HARNES
Street address of well location if in city: OF Highland	R.R. or street:
	City, state, zip code: Highland

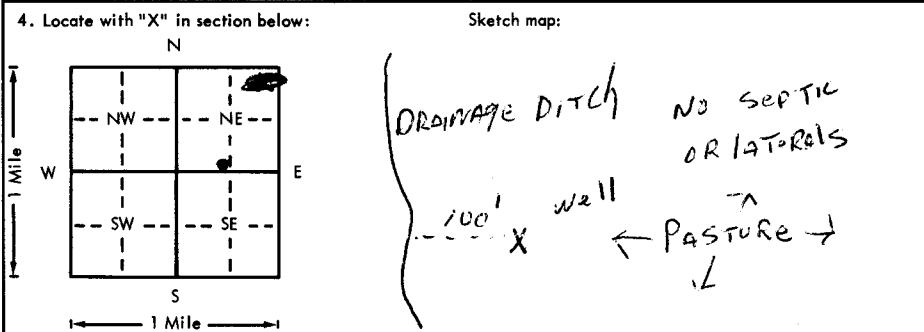

6. Bore hole dia. 10 in. Well depth 80 ft. Completion date 9-26-76
7. Cable tool <input checked="" type="checkbox"/> Rotary <input type="checkbox"/> Driven <input type="checkbox"/> Dug <input type="checkbox"/> Hollow rod <input type="checkbox"/> Jetted <input type="checkbox"/> Bored <input type="checkbox"/> Reverse rotary
8. Use: <input checked="" type="checkbox"/> Domestic <input type="checkbox"/> Public supply <input type="checkbox"/> Industry <input type="checkbox"/> Irrigation <input type="checkbox"/> Air conditioning <input type="checkbox"/> Stock <input type="checkbox"/> Lawn <input type="checkbox"/> Oil field water <input type="checkbox"/> Other
9. Casing: Material PVC Height: Above or below Threading: <input type="checkbox"/> Welded <input type="checkbox"/> Surface 2 1/2 in. RMP: PVC 9L Weight 2.58 lbs./ft. Dia. 5 in. to 80 ft. depth Wall Thickness: inches or Dia. 5 in. to 80 ft. depth gage No. 274

5. Type and color of material	From	To
TOPSOIL	0	4
BROWN Clay	4	59
COURSE SAND - GRAVEL	59	70
Shale (grey)	70	80
(Use a second sheet if needed)		

10. Screen: Manufacturer's name _____
Type PVC Dia. 5 Slot/gauze 20 Length 10 Set between 62 ft. and 72 ft. Gravel pack? <input checked="" type="checkbox"/> Size range of material 30 x 60
11. Static water level: 30 ft. below land surface Date 9-26-76 mo./day/yr.
12. Pumping level below land surfaces: _____ ft. after _____ hrs. pumping _____ g.p.m. Estimated maximum yield 30 g.p.m.
13. Water sample submitted: _____ mo./day/yr. Yes <input type="checkbox"/> No <input checked="" type="checkbox"/> Date _____
14. Well head completion: CAP Pitless adapter 24 inches above grade
15. Well grouted? <input checked="" type="checkbox"/> With: <input checked="" type="checkbox"/> Neat cement <input type="checkbox"/> Bentonite <input type="checkbox"/> Concrete Depth: From 5 ft. to 15 ft.
16. Nearest source of possible contamination: ft. 100 Direction W Type DRAINAGE Well disinfected upon completion? <input checked="" type="checkbox"/> Yes <input type="checkbox"/> No
17. Pump: <input checked="" type="checkbox"/> Not installed Manufacturer's name _____ Model number _____ HP _____ Volts _____ Length of drop pipe _____ ft. capacity _____ g.p.m. Type: _____ Submersible _____ Turbine _____ Jet _____ Reciprocating _____ Centrifugal _____ Other _____

18. Elevation: **905**
Topography: Hill Slope Upland Valley

19. Remarks: **OWNER WILL INSTALL SLAB**

20. Water well contractor's certification: This well was drilled under my jurisdiction and this report is true to the best of my knowledge and belief.
STRADER Dalg Co. Inc 182
Business name License No. Address **RT 1 Harton KS** Signed **Dale Robinson** Date **9-29-76** Authorized representative

BR = 835 D = 875

T 2 190 W R 3-190 W Sec 1/4 1/4 1/4 1/4