

WATER WELL RECORD

Form WWC-5

Division of Water Resources App. No.

[]


Well ID

MWIR

[X] Original Record [] Correction [] Change in Well Use

1 LOCATION OF WATER WELL: County Doniphan Fraction SE 1/4 SW 1/4 NW 1/4 SE 1/4 Section Number 9 Township Number T 1 S Range Number R 19 [X] E [] W

2 WELL OWNER: Last Name: Business: Wilbur-Ellis Address: 101 Hwy 7 Address: City White Cloud State: KS ZIP: Street or Rural Address where well is located (if unknown, distance and direction from nearest town or intersection): If at owner's address, check here: [] ~730' SE of Main St on E side of Hwy 7, White Cloud, KS

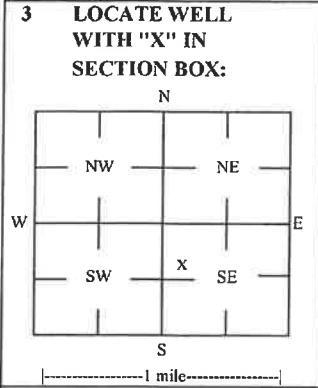

3 LOCATE WELL WITH "X" IN SECTION BOX: 4 DEPTH OF COMPLETED WELL: 23 ft Depth(s) Groundwater Encountered: 1) [] ft 2) [] ft 3) [] ft, or 4) [] Dry Well WELL'S STATIC WATER LEVEL: [] below land surface, measured on (mo-day-yr) [] above land surface, measured on (mo-day-yr) Pump test data: Well water was [] ft after [] hours pumping [] gpm Water well was [] ft after [] hours pumping [] gpm Estimated Yield: [] gpm Bore Hole Diameter: 7.25 in to [] ft, and [] in to [] ft

5 Latitude: 39.9770537 (decimal degrees) Longitude: -95.2924900 (decimal degrees) Horizontal Datum: [] WGS 84 [X] NAD 83 [] NAD 27 Source for Latitude/Longitude: [] GPS (unit make/model: []) (WAAS enabled? [] Yes [] No) [X] Land Survey [] Topographic Map [] Online Mapper

6 Elevation 852.20 ft [] Ground Level [X] TOC Source [X] Land Survey [] GPS [] Topographic Map [] Other []

7 WELL WATER TO BE USED AS: 1 Domestic: [] Household [] Lawn & Garden [] Livestock 2 [] Irrigation 3 [] Feedlot 4 [] Industrial 5 [] Public Water Supply: well ID 6 [] Dewatering: how many wells? 7 [] Aquifer Recharge: well ID 8 [X] Monitoring: well ID MWIR 9 Environmental Remediation: well ID [] Air Sparge [] Soil Vapor Extractor [] Recovery [] Injection 10 [] Oil Field Water Supply: lease 11 Test Hole: well ID [] Cased [] Uncased [] Geotechnical 12 Geothermal: How many bores? a) Closed Loop [] Horizontal [] Vertical b) Open Loop [] Surface Discharge [] Inj. of Water [] Other (specify): []

Was a chemical/bacteriological sample submitted to KDHE? [] Yes [X] No If yes, date sample was submitted: [] Water well disinfected? [] Yes [X] No

8 TYPE OF CASING USED: [] Steel [X] PVC [] Other CASING JOINTS: [] Glued [] Clamped [] Welded [X] Threaded Casing diameter 2 in. to 13 ft, Diameter [] in. to [] ft, Diameter [] in. to [] ft, Casing height above land surface [] in. Weight [] lbs./ft. Well thickness or gauge No [] TYPE OF SCREEN OR PERFORATION MATERIAL: [] Steel [] Stainless Steel [] Fiberglass [X] PVC [] Other (Specify) [] Brass [] Galvanized Steel [] Concrete tile [] None used (open hole) SCREEN OR PERFORATION OPENINGS ARE: [] Continuous Slot [X] Mill Slot [] Gauze Wrapped [] Torch Cut [] Drilled Holes [] Other (Specify) [] Louvered Shutter [] Key Punched [] Wire Wrapped [] Saw Cut [] None (Open Hole) SCREEN-PERFORATED INTERVALS: From 13 ft. to 23 ft, From [] ft. to [] ft, From [] ft. to [] ft, GRAVEL PACK INTERVALS: From 11 ft. to 23 ft, From [] ft. to [] ft, From [] ft. to [] ft, From [] ft. to [] ft,

9 GROUT MATERIAL: [] Neat cement [] Cement grout [X] Bentonite [X] Other Concrete: 0-0.5' Grout intervals: From 0.5 ft. to 11 ft, From [] ft. to [] ft, From [] ft. to [] ft,

Nearest source of possible contamination: [] Septic Tank [] Lateral Lines [] Pit Privy [] Livestock Pens [] Insecticide Storage [] Sewer Lines [] Cess Pool [] Sewage Lagoon [] Fuel Storage [] Abandoned Water Well [] Watertight Sewer Lines [] Seepage Pit [] Feedyard [] Fertilizer Storage [] Oil Well / Gas Well [X] Other (Specify) contaminated site Direction from well? 0 Distance from well? 0 ft

Table with columns: 10 FROM, TO, LITHOLOGIC LOG, FROM, TO, LITHO. LOG (cont.) or PLUGGING INTERVALS. Rows: 0-18, 18-21, 21-23.

Notes: KDHE ID: Wilbur-Ellis White Cloud Target of monitoring well is shallow groundwater, <20' of grout was installed at the direction of KDHE.

11 CONTRACTOR'S OR LANDOWNER'S CERTIFICATION: This water well was [X] constructed, [] reconstructed, or [] plugged under my jurisdiction and was completed on (mo-day-year) 10/6/22 and this record is true to the best of my knowledge and belief. Kansas Water Well Contractor's License No 757 This Water Well Record was completed on (mo-day-year) 10/25/22 under the business name of Larsen & Associates, Inc. Signature []



DATE:	JULY 2022
SCALE:	1"=110'
DRAWN BY:	ASR
APPROVED:	NG
FIGURE 2	

FORMER WILBUR-ELLIS: WHITE CLOUD FACILITY
101 HIGHWAY 7
WHITE CLOUD, KANSAS

SITE LAYOUT

RECEIVED
OCT 28 2022

LEGEND

- APPROXIMATE PROPERTY BOUNDARY
- STRUCTURAL ADDITION
- CONCRETE PAD
- MW-2
- MW-1
- MONITORING WELL (ABANDONED)
- MONITORING WELL (INACTIVE)
- CITY-OWNED WELL (INACTIVE)
- FORMER STRUCTURE (APPROXIMATE LOCATION)
- LEVEE

PHOTO SOURCE: GOOGLE EARTH IMAGE DATE APRIL 2016. DATE ACCESSED DECEMBER 2020.

KANSAS ENVIRONMENTAL

C11-Process - Wilbur-Ellis Company/Kansas White Cloud Overright/Master Use White Cloud Area
7/19/2022 3:23 PM

BUREAU OF WATER