


1	LOCATION OF WATER WELL:	Fraction	Section Number	Township Number	Range Number
	County: <u>Washington</u>	<u>1/4 1/4 1/4</u>	<u>20</u>	<u>1</u>	<u>2</u>

Distance and direction from nearest town or city street address of well if located within city?  
6 miles east and 2 1/2 south of Mahaska

2 WATER WELL OWNER: Gary Sproadling  
 RR#, St. Address, Box #: 8812 Shilling Shore CT Board of Agriculture, Division of Water Resources  
 City, State, ZIP Code: Oklahoma City, OK 73132 Application Number:

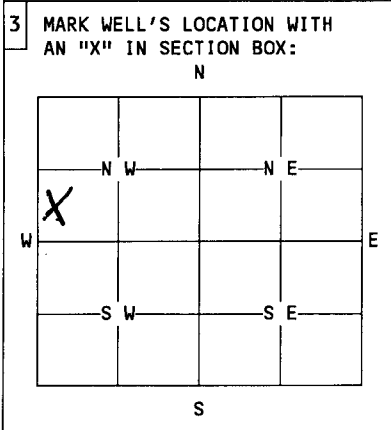

4 DEPTH OF WELL.....133.....ft.  
 WELL'S STATIC WATER LEVEL.....54.....ft. to H2O  
 WELL WAS USED AS:  
 1 Domestic     5 Public Water Supply     9 Dewatering  
 2 Irrigation     6 Oil Field Water Supply     10 Monitoring Well  
 3 Feedlot     7 Lawn and Garden Only     11 Injection Well  
 4 Industrial     8 Air Conditioning     12 Other.....  
 Was a chemical/bacteriological sample submitted to Department? Yes....No...  
 If yes, mo/day/yr sample was submitted.....  
 Water Well Disinfected: Yes...... No.....

5 TYPE OF BLANK CASING USED:  
 1 Steel     3 RMP (SR)     5 Wrought     7 Fiberglass     9 Other (specify below)  
 2 PVC     4 ABS     6 Asbestos-Cement     8 Concrete Tile  
 Blank casing diameter...4...in.    Was casing pulled? Yes...... No..... If yes, how much...6'...  
 Casing height above or below land and surface...12.....in.

6 GROUT PLUG MATERIAL: 1 Neat cement    2 Cement grout     3 Bentonite    4 Other.....  
 Grout Plug Intervals: From 4.5.ft. to 5.0.ft., From.....ft. to .....ft., From..... to.....ft.  
 What is the nearest source of possible contamination:  
 1 Septic tank     6 Seepage pit     11 Fuel storage     6 Other (specify below)  
 2 Sewer lines     7 Pit privy     12 Fertilizer storage    pasture  
 3 Watertight sewer lines     8 Sewage lagoon     13 Insecticide storage  
 4 Lateral lines     9 Feedyard     14 Abandoned water well  
 5 Cess Pool     10 Livestock pens     15 Oil well/Gas well  
 Direction from well? all sides    How many feet? immediately

FROM	TO	PLUGGING MATERIALS
<u>0</u>	<u>4.5</u>	<u>Topsoil</u>
<u>4.5</u>	<u>5.0</u>	<u>Bentonite Plug</u>
<u>5.0</u>	<u>54</u>	<u>Clay Soil</u>
<u>54</u>	<u>133</u>	<u>Chlorinated Sand</u>

7 CONTRACTOR'S OR LANDOWNER'S CERTIFICATION: This water well was plugged under my jurisdiction and was completed on (mo/day/year)..... and this record is true to the best of my knowledge and belief. Kansas Water Well Contractor's License No. .... This Water Well Record was completed on (mo/day/year)..... under the business name of .....  
 by (signature) Gene Secura (Contractor)

INSTRUCTIONS: Use typewriter or ball point pen. Please press firmly and print clearly. Please fill in blanks, underline or circle the correct answers. Send top three copies to Kansas Department of Health and Environment, Bureau of Water, Topeka, Kansas 66620-0001. Telephone: 913/296-3565. Send one to Water Well Owner and retain one for your records.