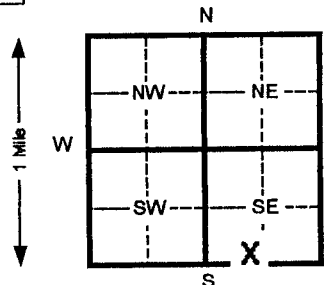


1 LOCATION OF WATER WELL: Fraction **SE ¼ SW ¼ SE ¼** Section Number **9** Township Number **T 1 S** Range Number **R 2 EW**
 County: **Washington**

Distance and direction from nearest town or city street address of well if located within city?
10 mi north of Morrowville

2 WATER WELL OWNER: **Fragger Farms**
 RR#, St. Address, Box #: **2779 King Rd.** Board of Agriculture, Division of Water Resources
 City, State, ZIP Code: **Morrowville KS 66958-9019** Application Number:

3 LOCATE WELL'S LOCATION WITH AN "X" IN SECTION BOX:


4 DEPTH OF COMPLETED WELL **360** ft. ELEVATION:
 Depth(s) Groundwater Encountered 1 **45** ft. 2 _____ ft. 3 _____ ft.
 WELL'S STATIC WATER LEVEL **45** ft. below land surface measured on **mo/day/yr** **7-13-02**
 Pump test data: Well water was _____ ft. after _____ hours pumping _____ gpm
 Est. Yield _____ gpm: Well water was _____ ft. after _____ hours pumping _____ gpm
 Bore Hole Diameter **6.25** in. to _____ ft. and _____ in. to _____ ft.
 WELL WATER TO BE USED AS: 5 Public water supply 8 Air conditioning 11 Injection well
 1 Domestic 3 Feed lot 6 Oil field water supply 9 Dewatering 12 Other (Specify below)
 2 Irrigation 4 Industrial 7 Lawn and garden (domestic) 10 Monitoring well
 Was a chemical/bacteriological sample submitted to Department? Yes _____ No **X** If yes, mo/day/yr sample was submitted _____
 Water Well Disinfected? Yes **X** No _____

5 TYPE OF BLANK CASING USED:
 1 Steel 3 RMP (SR) 5 Wrought Iron 8 Concrete tile CASING JOINTS: Glued **X** Clamped _____
 2 PVC 4 ABS 6 Asbestos-Cement 9 Other (specify below) Welded _____
 7 Fiberglass Threaded _____
 Blank casing diameter **2** in. to _____ ft., Dia _____ in. to _____ ft., Dia _____ in. to _____ ft.
 Casing height above land surface **24** in., weight _____ lbs./ft. Wall thickness or gauge No. **SCH-40**
 TYPE OF SCREEN OR PERFORATION MATERIAL:
 1 Steel 3 Stainless steel 5 Fiberglass 8 RMP (SR) 10 Asbestos-cement 11 Other (specify) _____
 2 Brass 4 Galvanized steel 6 Concrete tile 9 ABS 12 None used (open hole)
 SCREEN OR PERFORATION OPENINGS ARE:
 1 Continuous slot 3 Mill slot 5 Gauzed wrapped 8 Saw cut 11 None (open hole)
 2 Louvered shutter 4 Key punched 6 Wire wrapped 9 Drilled holes
 7 Torch cut 10 Other (specify) _____
 SCREEN-PERFORATED INTERVALS: From **110** ft. to **120** ft. From **160** ft. to **180** ft.
 From **260** ft. to **280** ft. From **340** ft. to **360** ft.
 GRAVEL PACK INTERVALS: From **20** ft. to **360** ft. From _____ ft. to _____ ft.
 From _____ ft. to _____ ft. From _____ ft. to _____ ft.

6 GROUT MATERIAL: 1 Neat cement 2 Cement grout 3 Bentonite 4 Other _____
 Grout Intervals From **0** ft. to **20** ft. From _____ ft. to _____ ft. From _____ ft. to _____ ft.
 What is the nearest source of possible contamination:
 1 Septic tank 4 Lateral lines 7 Pit privy 10 Livestock pens 14 Abandoned water well
 2 Sewer lines 5 Cess pool 8 Sewage lagoon 11 Fuel storage 15 Oil well/ Gas well
 3 Watertight sewer lines 6 Seepage pit 9 Feedyard 12 Fertilizer storage 16 Other (specify below)
 13 Insecticide storage **None observed**

Direction from well? _____ How many feet? _____

FROM	TO	CODE	LITHOLOGIC LOG	FROM	TO	PLUGGING INTERVALS
0	38		Topsoil & brown clay	320	340	Sandstone & gray clay
38	109		Gray cemented sand; lit clay	340	356	Sandstone & clay mix; hard
109	110		Iron pyrite	356	360	Rock, very hard
110	122		Sandstone; little clay			
122	177		Gray clay			
177	182		Sandstone, gray clay			
182	233		Gray & red clay			
233	236		Iron pyrite			
236	240		Red & gray clay			
240	255		Sandstone & clay mix			
255	260		Gray clay & sandstone			
260	276		Sandstone & some clay			
276	280		Rock; very hard			
280	320		Gray & red clay			

7 CONTRACTOR'S OR LANDOWNER'S CERTIFICATION: This water well was (1) constructed, (2) reconstructed, or (3) plugged under my jurisdiction and was **constructed**
 completed on (mo/day/yr) **6-12-02** and this record is true to the best of my knowledge and belief. Kansas
 Water Well Contractor's License No. **473** This Water Well Record was completed on (mo/day/yr) **7-12-02**
 under the business name of **Tyler Water Well Service, Inc.** by (signature) *[Signature]*
 INSTRUCTIONS: Please fill in blanks and circle the correct answers. Send three copies to Kansas Department of Health and Environment, Bureau of Water, Topeka, Kansas 66620-0001. Telephone: 913-296-5545. Send one to WATER WELL OWNER and retain one for your records.

OFFICE USE ONLY