


1 LOCATION OF WATER WELL: Fraction  $\frac{1}{4}$  NW  $\frac{1}{4}$  NE  $\frac{1}{4}$  Section Number 1 Township Number T 1 S Range Number R 2 EW  
 County: Washington

Distance and direction from nearest town or city street address of well if located within city?

~~1/2~~ 1/2 miles West of Mahaska

2 WATER WELL OWNER: Kirk Willoughby  
 RR#, St. Address, Box # : 70489 559 Ave.  
 City, State, ZIP Code : Reynolds NE 68429  
 Board of Agriculture, Division of Water Resources  
 Application Number:

3 LOCATE WELL'S LOCATION WITH AN "X" IN SECTION BOX: 4 DEPTH OF COMPLETED WELL 140 ft. ELEVATION: UNKNOWN

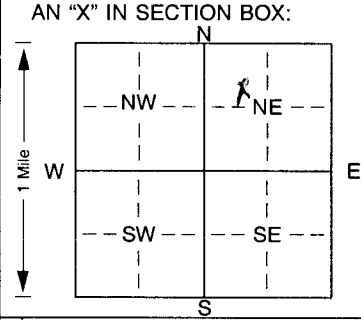

Depth(s) Groundwater Encountered 1 ft. 2. ft. 3. ft.  
 WELL'S STATIC WATER LEVEL 44 ft. below land surface measured on mo/day/yr 8/26/03  
 Pump test data: Well water was . . . . . ft. after . . . . . hours pumping . . . . . gpm  
 Est. Yield 10 . . . . . gpm: Well water was . . . . . ft. after . . . . . hours pumping . . . . . gpm  
 Bore Hole Diameter . 10 . . . . . in. to 140 . . . . . ft., and . . . . . in. to . . . . . ft.  
 WELL WATER TO BE USED AS: 5 Public water supply 8 Air conditioning 11 Injection well  
 1 Domestic 3 Feedlot 6 Oil field water supply 9 Dewatering 12 Other (Specify below)  
 2 Irrigation 4 Industrial 7 Domestic (lawn & garden) 10 Monitoring well . . . . . Livestock  
 Was a chemical/bacteriological sample submitted to Department? Yes. . . . . No. X ; If yes, mo/day/yr sample was submitted  
 Water Well Disinfected? Yes X No

5 TYPE OF BLANK CASING USED: 1 Steel 3 RMP (SR) 5 Wrought iron 8 Concrete tile CASING JOINTS: Glued. X Clamped.  
 2 PVC 4 ABS 6 Asbestos-Cement 9 Other (specify below) Welded  
 7 Fiberglass Threaded

Blank casing diameter . . . . . 5 . . . . . in. to 80 . . . . . ft., Dia . . . . . in. to . . . . . ft., Dia . . . . . in. to . . . . . ft.  
 Casing height above land surface . . . . . 24 . . . . . in., weight . . . . . 2.893 . . . . . lbs./ft. Wall thickness or gauge No. . . . . 0.245

TYPE OF SCREEN OR PERFORATION MATERIAL: 1 Steel 3 Stainless steel 5 Fiberglass 8 RMP (SR) 10 Asbestos-cement  
 2 Brass 4 Galvanized steel 6 Concrete tile 9 ABS 11 Other (specify) 12 None used (open hole)

SCREEN OR PERFORATION OPENINGS ARE: 1 Continuous slot 3 Mill slot 5 Gauzed wrapped 8 Saw cut 11 None (open hole)  
 2 Louvered shutter 4 Key punched 6 Wire wrapped 7 Torch cut 9 Drilled holes 10 Other (specify) . . . . . ft.

SCREEN-PERFORATED INTERVALS: From 80 . . . . . ft. to 140 . . . . . ft., From . . . . . ft. to . . . . . ft., From . . . . . ft. to . . . . . ft.  
 GRAVEL PACK INTERVALS: From 25 . . . . . ft. to 140 . . . . . ft., From . . . . . ft. to . . . . . ft., From . . . . . ft. to . . . . . ft.

6 GROUT MATERIAL: 1 Neat cement 2 Cement grout 3 Bentonite 4 Other  
 Grout Intervals: From 5 . . . . . ft. to 25 . . . . . ft., From . . . . . ft. to . . . . . ft., From . . . . . ft. to . . . . . ft.

What is the nearest source of possible contamination:  
 1 Septic tank 4 Lateral lines 7 Pit privy 10 Livestock pens 14 Abandoned water well  
 2 Sewer lines 5 Cess pool 8 Sewage lagoon 11 Fuel storage 15 Oil well/Gas well  
 3 Watertight sewer lines 6 Seepage pit 9 Feedyard 12 Fertilizer storage 16 Other (specify below)  
 13 Insecticide storage  
 Direction from well? None How many feet?

FROM	TO	LITHOLOGIC LOG	FROM	TO	PLUGGING INTERVALS
0	3	Top Soil			
3	42	Tan & Brown Clay			
42	72	Gray & Tan Clay			
72	79	Gray Clay			
79	107	Red sandstone			
107	113	Gray Sandstone			
113	117	Soft Gray Clay			
117	142	Gray Sandstone			
142	146	Limestone			

7 CONTRACTOR'S OR LANDOWNER'S CERTIFICATION: This water well was (1) constructed, (2) reconstructed, or (3) plugged under my jurisdiction and was completed on (mo/day/year) 8-26-03 and this record is true to the best of my knowledge and belief. Kansas Water Well Contractor's Licence No. 480 This Water Well Record was completed on (mo/day/yr) 8/26/03 under the business name of Williams Drilling Co Inc by (signature) K. Williams