

**WATER WELL RECORD Form WWC-5**


Original Record  Correction  Change in Well Use

Division of Water Resources App. No.

Well ID

**1 LOCATION OF WATER WELL:** Fraction 1/4 SW 1/4 NW 1/4 SW 1/4 Section Number 3 Township Number T 1 S Range Number R 2 E W  
 County: WASHINGTON

**2 WELL OWNER:** Last Name: LAKE First: LEI  
 Business: LAKE VALLEY VIEW LLC  
 Address: 500 4TH STREET  
 City: FAIRBURY State: NE ZIP: 68352  
 Street or Rural Address where well is located (if unknown, distance and direction from nearest town or intersection): 8 EAST 2 1/4 NORTH OF MAHASKA, KS

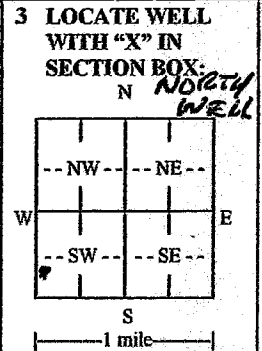

**4 DEPTH OF COMPLETED WELL:** 315 ft.  
 Depth(s) Groundwater Encountered: 1) ..... ft.  
 2) ..... ft. 3) ..... ft., or 4)  Dry Well  
 WELL'S STATIC WATER LEVEL: 258 ft.  
 below land surface, measured on (mo-day-yr) 3/11/2017  
 above land surface, measured on (mo-day-yr) .....  
 Pump test data: Well water was ..... ft.  
 after ..... hours pumping ..... gpm  
 Well water was ..... ft.  
 after ..... hours pumping ..... gpm  
 Estimated Yield: 25 gpm  
 Bore Hole Diameter: 10 in. to 3.25 ft. and ..... in. to ..... ft.

**5 Latitude:** 39° 59' 38.8" N (decimal degrees)  
**Longitude:** 97° 12' 34.4" W (decimal degrees)  
 Horizontal Datum:  WGS 84  NAD 83  NAD 27  
 Source for Latitude/Longitude: MAGELLAN  
 GPS (unit make/model: EXPLORIST GC)  
 (WAAS enabled?  Yes  No)  
 Land Survey  Topographic Map  
 Online Mapper: .....

**6 Elevation:** ..... ft.  Ground Level  TOC  
 Source:  Land Survey  GPS  Topographic Map  
 Other .....

**7 WELL WATER TO BE USED AS:**

1. Domestic:  Household  Lawn & Garden  Livestock  
 2.  Irrigation  
 3.  Feedlot  
 4.  Industrial  
 5.  Public Water Supply: well ID .....  
 6.  Dewatering: how many wells? .....  
 7.  Aquifer Recharge: well ID .....  
 8.  Monitoring: well ID .....  
 9. Environmental Remediation: well ID .....  
 Air Sparge  Soil Vapor Extraction  
 Recovery  Injection  
 10.  Oil Field Water Supply: lease .....  
 11. Test Hole: well ID .....  
 Cased  Uncased  Geotechnical  
 12. Geothermal: how many bores? .....  
 a) Closed Loop  Horizontal  Vertical  
 b) Open Loop  Surface Discharge  Inj. of Water  
 13.  Other (specify): .....

Was a chemical/bacteriological sample submitted to KDHE?  Yes  No If yes, date sample was submitted: .....

**8 TYPE OF CASING USED:**  Steel  PVC  Other ..... CASING JOINTS:  Glued  Clamped  Welded  Threaded  
 Casing diameter 5 in. to 2.75 ft., Diameter ..... in. to ..... ft., Diameter ..... in. to ..... ft.  
 Casing height above land surface 18 in. Weight 2.8 lbs./ft. Wall thickness or gauge No. 2.65 .....

TYPE OF SCREEN OR PERFORATION MATERIAL:  
 Steel  Stainless Steel  Fiberglass  PVC  Other (Specify) .....  
 Brass  Galvanized Steel  Concrete tile  None used (open hole)

SCREEN OR PERFORATION OPENINGS ARE:  
 Continuous Slot  Mill Slot  Gauze Wrapped  Torch Cut  Drilled Holes  Other (Specify) .....  
 Louvered Shutter  Key Punched  Wire Wrapped  Saw Cut  None (Open Hole)

SCREEN-PERFORATED INTERVALS: From 2.75 ft. to 31.5 ft., From ..... ft. to ..... ft., From ..... ft. to ..... ft.  
 GRAVEL PACK INTERVALS: From 2.5 ft. to 31.5 ft., From ..... ft. to ..... ft., From ..... ft. to ..... ft.

**9 GROUT MATERIAL:**  Neat cement  Cement grout  Bentonite  Other .....  
 Grout Intervals: From 5 ft. to 2.5 ft., From ..... ft. to ..... ft., From ..... ft. to ..... ft.

Nearest source of possible contamination:  
 Septic Tank  Lateral Lines  Pit Privy  Livestock Pens  Insecticide Storage  
 Sewer Lines  Cess Pool  Sewage Lagoon  Fuel Storage  Abandoned Water Well  
 Watertight Sewer Lines  Seepage Pit  Feedyard  Fertilizer Storage  Oil Well/Gas Well  
 Other (Specify) NONE PRESENT  
 Direction from well? ..... Distance from well? ..... ft.

10 FROM	TO	LITHOLOGIC LOG	FROM	TO	LITHO. LOG (cont.) or PLUGGING INTERVALS
0	2	TOPSOIL			
2	9	BROWN CLAY			
9	34	LIMESTONE & YELLOW SHALE			
34	100	GRAY SHALE			
100	170	SOAPSTONE			
170	290	RED & WHITE CLAY			
290	315	SANDSTONE			
315	325	GRAY SILT			

Notes: .....

**11 CONTRACTOR'S OR LANDOWNER'S CERTIFICATION:** This water well was  constructed,  reconstructed, or  plugged under my jurisdiction and was completed on (mo-day-year) 3/11/2017 and this record is true to the best of my knowledge and belief. Kansas Water Well Contractor's License No. 518. This Water Well Record was completed on (mo-day-year) 3/20/2017 under the business name of BLUE VALLEY DRILLING Signature [Signature]