


1 LOCATION OF WATER WELL: County: Washington Fraction NW 1/4 NW 1/4 NE 1/4 NE 1/4 Section Number 24 Township Number T 1 S Range Number R 2 E W

2 WELL OWNER: Last Name: _____ First: _____
 Business: Fragar Farms
 Address: 1234 26th Rd.
 Address: _____
 City: Morrowville State: KS ZIP: 66958
 Street or Rural Address where well is located (if unknown, distance and direction from nearest town or intersection): Approximately 8 miles north and 1 mile east of Morrowville. If at owner's address, check here:

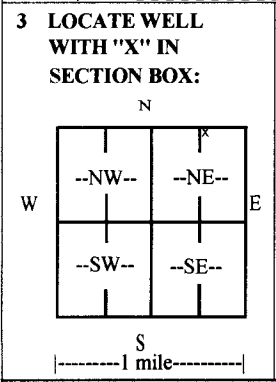

4 DEPTH OF COMPLETED WELL: 91 ft.
 Depth(s) Groundwater Encountered: 1) _____ ft.
 2) _____ ft. 3) _____ ft., or 4) Dry Well
 WELL'S STATIC WATER LEVEL: 21 ft.
 below land surface, measured on (mo-day-yr) 12/07/17
 above land surface, measured on (mo-day-yr) _____
 Pump test data: Well water was not checked ft.
 after _____ hours pumping _____ gpm
 Well water was _____ ft.
 after _____ hours pumping _____ gpm
 Estimated Yield: _____ gpm
 Bore Hole Diameter: 26 in. to 150 ft. and _____ in. to _____ ft.

5 Latitude: 39.958524 (decimal degrees)
Longitude: -97.147529 (decimal degrees)
 Horizontal Datum: WGS 84 NAD 83 NAD 27
 Source for Latitude/Longitude: GPS (unit make/model: _____) (WAAS enabled? Yes No)
 Land Survey Topographic Map
 Online Mapper:

6 Elevation: Unknown ft. Ground Level TOC
 Source: Land Survey GPS Topographic Map
 Other _____

7 WELL WATER TO BE USED AS:

1. Domestic: Household Lawn & Garden Livestock Irrigation

2. Feedlot Industrial

3. Public Water Supply: well ID _____

4. Dewatering: how many wells? _____

5. Aquifer Recharge: well ID _____

6. Monitoring: well ID _____

7. Environmental Remediation: well ID _____

8. Air Sparge Soil Vapor Extraction Recovery Injection

9. Oil Field Water Supply: lease _____

10. Test Hole: well ID _____

11. Cased Uncased Geotechnical

12. Geothermal: how many bores? _____

a) Closed Loop Horizontal Vertical

b) Open Loop Surface Discharge Inj. of Water

13. Other (specify): _____

Was a chemical/bacteriological sample submitted to KDHE? Yes No If yes, date sample was submitted: _____
 Water well disinfected? Yes No

8 TYPE OF CASING USED: Steel PVC CASING JOINTS: Glued Clamped Welded Threaded Other
 Casing diameter 16 in. to 30 ft., Diameter _____ in. to _____ ft., Diameter _____ in. to _____ ft.
 Casing height above land surface 12 in. Weight 19.75 lbs./ft. Wall thickness or gauge No. .616
 TYPE OF SCREEN OR PERFORATION MATERIAL: Steel Stainless Steel Fiberglass PVC Other (Specify) _____
 Brass Galvanized Steel Concrete tile None used (open hole)
 SCREEN OR PERFORATION OPENINGS ARE: Continuous Slot Mill Slot Gauze Wrapped Torch Cut Drilled Holes Other (Specify) _____
 Louvered Shutter Key Punched Wire Wrapped Saw Cut None (Open Hole)
 SCREEN-PERFORATED INTERVALS: From 30 ft. to 90 ft., From _____ ft. to _____ ft., From _____ ft. to _____ ft.
 GRAVEL PACK INTERVALS: From 25 ft. to 150 ft., From _____ ft. to _____ ft., From _____ ft. to _____ ft.

9 GROUT MATERIAL: Neat cement Cement grout Bentonite Other
 Grout Intervals: From 0 ft. to 25 ft., From _____ ft. to _____ ft., From _____ ft. to _____ ft.

Nearest source of possible contamination:

Septic Tank Lateral Lines Pit Privy Livestock Pens Insecticide Storage
 Sewer Lines Cess Pool Sewage Lagoon Fuel Storage Abandoned Water Well
 Watertight Sewer Lines Seepage Pit Feedyard Fertilizer Storage Oil Well/Gas Well
 Other (Specify) None Known
 Direction from well? _____ Distance from well? _____ ft.

10 FROM	TO	LITHOLOGIC LOG	FROM	TO	LITHO. LOG (cont.) or PLUGGING INTERVALS
0	4	Topsoil	77	79	Sandstone, hard
4	24	Clay, brown	79	82	Sand & gravel, fine to medium
24	34	Sandstone, medium	82	143	Clay, gray, red (dakota), very sticky
34	35	Clay, gray	143	145	Clay, brown, yellow, small sandstone streaks
35	50	Sand & gravel, fine to medium, sandstone & shale streaks	145	147	Clay, gray
50	52	Clay, gray & yellow	147	150	Clay, red
52	60	Clay, sandy, sand & gravel streaks	Notes:		
60	61	Ironpyrite			
61	77	Sandstone, gravel, ironpyrite streaks			

11 CONTRACTOR'S OR LANDOWNER'S CERTIFICATION: This water well was constructed, reconstructed, or plugged under my jurisdiction and was completed on (mo-day-year) 12/07/17 and this record is true to the best of my knowledge and belief.
 Kansas Water Well Contractor's License No. 185 This Water Well Record was completed on (mo-day-year) 12/11/17
 under the business name of Clarke Well & Equipment, Inc. Signature _____