


1 LOCATION OF WATER WELL:	Fraction	Section Number	Township Number	Range Number
County: <del>Washington</del>	NE ¼ NW ¼ NE ¼	13	T 1 S	R 2 E/W

Distance and direction from nearest town or city street address of well if located within city?  
9 North 11 $\frac{1}{2}$  East Morrowville Ks.

2] WATER WELL OWNER: <b>KENNETH WAHL</b>		
RR#, St. Address, Box #	<b>Rt. 1</b>	Board of Agriculture, Division of Water Resources
City, State, ZIP Code	<b>Morrowville Ks.</b>	Application Number:

LOCATE WELL'S LOCATION WITH AN "X" IN SECTION BOX: 4 DEPTH OF COMPLETED WELL: 110 ft. ELEVATION: \_\_\_\_\_

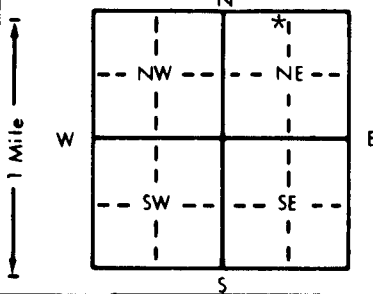

4 DEPTH OF COMPLETED WELL 110 ft. ELEVATION: \_\_\_\_\_

Depth(s) Groundwater Encountered 1. \_\_\_\_\_ ft. 2. \_\_\_\_\_ ft. 3. \_\_\_\_\_ ft.

WELL'S STATIC WATER LEVEL 72 ft. below land surface measured on mo/day/yr 4/2/92

Pump test data: Well water was \_\_\_\_\_ ft. after \_\_\_\_\_ hours pumping \_\_\_\_\_ gpm

Est. Yield 4.0 gpm: Well water was \_\_\_\_\_ ft. after \_\_\_\_\_ hours pumping \_\_\_\_\_ gpm

Bore Hole Diameter 10 in. to 110 ft., and \_\_\_\_\_ in. to \_\_\_\_\_ ft.

WELL WATER TO BE USED AS:

5 Public water supply	8 Air conditioning	11 Injection well
<u>1</u> Domestic	3 Feedlot	6 Oil field water supply
		9 Dewatering
2 Irrigation	4 Industrial	7 Lawn and garden only
		10 Monitoring well

12 Other (Specify below) \_\_\_\_\_

Was a chemical/bacteriological sample submitted to Department? Yes \_\_\_\_\_ No \* \_\_\_\_\_; If yes, mo/day/yr sample was submitted \_\_\_\_\_

Water Well Disinfected? Yes \* \_\_\_\_\_ No \_\_\_\_\_

5 TYPE OF BLANK CASING USED:		5 Wrought iron	8 Concrete tile	CASING JOINTS: Glued * . . . . Clamped . . . . .
1 Steel	3 RMP (SR)	6 Asbestos-Cement	9 Other (specify below)	Welded . . . . .
2 PVC	4 ABS	7 Fiberglass		Threaded . . . . .

Blank casing diameter . . . . . 5 . . . . . in. to . . . . . 90 . . . . . ft., Dia . . . . . in. to . . . . . ft., Dia . . . . . in. to . . . . . ft.  
Casing height above land surface . . . . . 12 . . . . . in. weight . . . . . 200 lbs. . . . . lbs./ft. Wall thickness or gauge No. . . . .

TYPE OF SCREEN OR PERFORATION MATERIAL:			7 PVC	10 Asbestos-cement
1 Steel	fff	3 Stainless steel	8 RMP (SR)	11 Other (specify) .....
2 Brass		4 Galvanized steel	9 ABS	12 None used (open hole)

SCREEN OR PERFORATION OPENINGS ARE:		5 Gauzed wrapped	8 Saw cut	11 None (open hole)
<u>1 Continuous slot</u>	3 Mill slot	6 Wire wrapped	9 Drilled holes	
2 Louvered shutter	4 Key punched	7 Torch cut	10 Other (specify) .....	

SCREEN-PERFORATED INTERVALS:	From	90	ft. to	110	ft., From		ft. to		ft.
	From		ft. to		ft., From		ft. to		ft.
GRAVEL PACK INTERVALS:	From	30	ft. to	110	ft., From		ft. to		ft.
	From		ft. to		ft., From		ft. to		ft.

6 GROUT MATERIAL: 1 Neat cement 2 Cement grout 3 Bentonite 4 Other \_\_\_\_\_  
Grout Intervals: From 0 ft. to 30 ft., From \_\_\_\_\_ ft. to \_\_\_\_\_ ft., From \_\_\_\_\_ ft. to \_\_\_\_\_ ft.

What is the nearest source of possible contamination:

1 Septic tank	4 Lateral lines	7 Pit privy	10 Livestock pens	14 Abandoned water well
<u>2 Sewer lines</u>	5 Cess pool	8 Sewage lagoon	11 Fuel storage	15 Oil well/Gas well
3 Watertight sewer lines	6 Seepage pit	9 Feedyard	12 Fertilizer storage	16 Other (specify below)
			13 Insecticide storage	.....

Direction from well? NE How many feet? 200

[illegible]

7. CONTRACTOR'S OR LANDOWNER'S CERTIFICATION: This water well was (1) constructed, (2) reconstructed, or (3) plugged under my jurisdiction and was completed on (mo/day/year) 4/2/92 and this record is true to the best of my knowledge and belief. Kansas Water Well Contractor's License No. 518 This Water Well Record was completed on (mo/day/yr) 4/2/92 under the business name of **BLUE VALLEY DRILLING** by (signature) Eric Stadler

INSTRUCTIONS: Use typewriter or ball point pen. PLEASE PRESS FIRMLY and PRINT clearly. Please fill in blanks, underline or circle the correct answers. Send top three copies to Kansas Department of Health and Environment, Bureau of Water, Topeka, Kansas 66620-7320. Telephone: 913-296-5545. Send one to WATER WELL OWNER and retain one for your records.