


USE TYPEWRITER OR BALL POINT PEN-PRESS FIRMLY, PRINT CLEARLY.

WATER WELL RECORD
KSA 82a-1201-1215

Kansas Department of Health and Environment-Division of Environment (Water well Contractors) Topeka, Kansas 66620

1. Location of well: County Washington Xaction NW 1/4 NW 1/4 NW 1/4 Section number 23 Township number T 1 S. Range number S R 2 E E/W

2. Distance and direction from nearest town or city: 2 1/2 miles north of Morrowville + 1/2 mile west south side road 3. Owner of well: Earl Goebel
Street address of well location if in city: RR 1 City, state, zip code: Marsha Kans

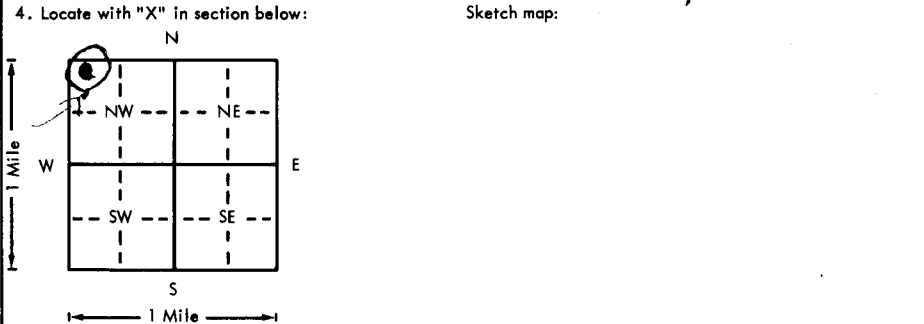

6. Bore hole dia. 10 in. Completion date 5-17-76
Well depth 114 ft.
7. Cable tool Rotary Driven Dug
 Hollow rod Jetted Bored Reverse rotary
8. Use: Domestic Public supply Industry
 Irrigation Air conditioning Stock
 Lawn Oil field water Other
9. Casing: Material PVC Height: Above or below
Threaded Welded Surface T3 in.
RMP PVC Weight lbs./ft.
Dia. 5 in. to 114 ft. depth Wall Thickness, inches or
Dia. in. to ft. depth gage No. Sch. 40

5. Type and color of material	From	To
<u>top soil</u>	<u>0</u>	<u>2</u>
<u>yellow limestone</u>	<u>2</u>	<u>19</u>
<u>Blue shale</u>	<u>19</u>	<u>47</u>
<u>Blue shale</u>	<u>47</u>	<u>77</u>
<u>Porous white shale rock</u>	<u>77</u>	<u>80</u>
<u>Blue shale sticky</u>	<u>80</u>	<u>114</u>
(Use a second sheet if needed)		

Screen: Manufacturer's name Pumpco
Type PVC M.P.L. Dia. 5"
Slot/gauge 0.30 Length 40
Set between 54 ft. and 74 ft.
Set between ft. and ft.
Gravel pack? Size range of material 1/8" to 1/4"
11. Static water level: 40 ft. below land surface Date 5-14-76 mo./day/yr.
12. Pumping level below land surfaces: Baler test
 ft. after hrs. pumping g.p.m.
 ft. after hrs. pumping g.p.m.
Estimated maximum yield 7 g.p.m.
13. Water sample submitted: mo./day/yr.
Yes No Date
14. Well head completion: NA
 Pitless adapter inches above grade
 Well grouted?
With: Neat cement Bentonite Concrete
Depth: From 15 ft. to 4 ft.
16. Nearest source of possible contamination: cattle yd
ft. 200 Direction South East type
Well disinfected upon completion? Yes No
17. Pump: Not installed
Manufacturer's name
Model number HP Volts
Length of drop pipe ft. capacity g.p.m.
Type:
 Submersible Turbine
 Jet Reciprocating
 Centrifugal Other

18. Elevation: 1520 ft
Topography: Hill Slope Upland Valley
19. Remarks:

20. Water well contractor's certification:
This well was drilled under my jurisdiction and this report is true to the best of my knowledge and belief.
Strader Drilling Co 237
Business name Blue Rapids License No.
Address
Signed Harold Strader Date 5-17-76
Authorized representative

T 1 S. R 2 E S 23 NW 1/4 NW 1/4 NW 1/4