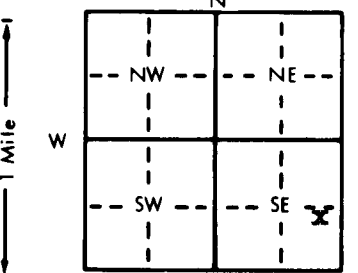


1 LOCATION OF WATER WELL: Fraction **NE 1/4 SE 1/4 SE 1/4** Section Number **17** Township Number **T 1 S** Range Number **R 3 E**
 County: **Washington**

Distance and direction from nearest town or city street address of well if located within city?
1 1/2 North, 3 1/2 East, 1/4 North of Morrowville

2 WATER WELL OWNER: **Lanny Lindsley**
 RR#, St. Address, Box # : **Route 2** Board of Agriculture, Division of Water Resources
 City, State, ZIP Code : **Morrowville, Kansas 66958** Application Number:

3 LOCATE WELL'S LOCATION WITH AN "X" IN SECTION BOX:

 4 DEPTH OF COMPLETED WELL: **188** ft. ELEVATION: **1480.7**
 Depth(s) Groundwater Encountered 1 **1** ft. 2 **1** ft. 3 **1** ft.
 WELL'S STATIC WATER LEVEL **160** ft. below land surface measured on mo/day/yr **3/30/84**
 Pump test data: Well water was **NA** ft. after **NA** hours pumping **NA** gpm
 Est. Yield **15** gpm: Well water was **NA** ft. after **NA** hours pumping **NA** gpm
 Bore Hole Diameter **8** in. to **188** ft., and **8** in. to **188** ft.
 WELL WATER TO BE USED AS:
 Domestic 3 Feedlot 6 Oil field water supply 9 Dewatering 12 Other (Specify below)
 2 Irrigation 4 Industrial 7 Lawn and garden only 10 Observation well
 Was a chemical/bacteriological sample submitted to Department? Yes No ; If yes, mo/day/yr sample was submitted
 Water Well Disinfected? Yes No

5 TYPE OF BLANK CASING USED:
 1 Steel 3 RMP (SR) 5 Wrought iron 8 Concrete tile CASING JOINTS: Glued Clamped
 PVC 4 ABS 6 Asbestos-Cement 9 Other (specify below) Welded
 7 Fiberglass Threaded
 Blank casing diameter **5** in. to **148** ft., Dia **5** in. to **148** ft., Dia **5** in. to **148** ft.
 Casing height above land surface **12** in., weight **3** lbs./ft. Wall thickness or gauge No. **.258**
 TYPE OF SCREEN OR PERFORATION MATERIAL:
 PVC 10 Asbestos-cement
 1 Steel 3 Stainless steel 5 Fiberglass 8 RMP (SR) 11 Other (specify)
 2 Brass 4 Galvanized steel 6 Concrete tile 9 ABS 12 None used (open hole)
 SCREEN OR PERFORATION OPENINGS ARE:
 1 Continuous slot 3 Mill slot 5 Gauzed wrapped 8 Saw cut 11 None (open hole)
 2 Louvered shutter 4 Key punched 6 Wire wrapped 9 Drilled holes
 7 Torch cut 10 Other (specify)
 SCREEN-PERFORATED INTERVALS: From **148** ft. to **188** ft., From ft. to ft.
 From ft. to ft., From ft. to ft.
 GRAVEL PACK INTERVALS: From **14** ft. to **188** ft., From ft. to ft.
 From ft. to ft., From ft. to ft.

6 GROUT MATERIAL: Neat cement 2 Cement grout 3 Bentonite 4 Other
 Grout Intervals: From **4** ft. to **14** ft., From ft. to ft., From ft. to ft.
 What is the nearest source of possible contamination:
 Septic tank 4 Lateral lines 7 Pit privy 10 Livestock pens 14 Abandoned water well
 2 Sewer lines 5 Cess pool 8 Sewage lagoon 11 Fuel storage 15 Oil well/Gas well
 3 Watertight sewer lines 6 Seepage pit 9 Feedyard 12 Fertilizer storage 16 Other (specify below)
 13 Insecticide storage
 Direction from well? **South** How many feet? **70**

FROM	TO	LITHOLOGIC LOG	FROM	TO	LITHOLOGIC LOG
0	3	0 / topsoil			
3	14	0 / sandy clay			
14	21	blue clay			
21	27	red clay			
27	60	0 / brown clay			
60	100	23 blue red clay w/ sandrock layers			
100	121	blue clay			
121	126	0 / brown clay			
126	130	23 sandrock			
130	143	0 / blue clay			
143	190	23 sandrock			
190		stop			

7 CONTRACTOR'S OR LANDOWNER'S CERTIFICATION: This water well was ~~not~~ constructed, (2) reconstructed, or (3) plugged under my jurisdiction and was completed on (mo/day/year) **3/30/1984** and this record is true to the best of my knowledge and belief. Kansas Water Well Contractor's License No. **359** This Water Well Record was completed on (mo/day/yr) **4/19/1984** under the business name of **Daryl Cox & Sons Inc.** by (signature) *Daryl Cox*

INSTRUCTIONS: Use typewriter or ball point pen, PLEASE PRESS FIRMLY and PRINT clearly. Please fill in blanks, underline or circle the correct answers. Send top three copies to Kansas Department of Health and Environment, Division of Environment, Environmental Geology Section, Topeka, KS 66620. Send one to WATER WELL OWNER and retain one for your records.

OFFICE USE ONLY
T
H
W
DM
SEC
17
10E14
SE 1/4

B