WATER WELL RECORD Form WWC-5 KSA 82a-1212

1 LOCATION OF WATER WELL: County: Washington | Fraction: NE¼ NE¼ NW¼ | Section Number: 11 | Township Number: T 1 S | Range Number: R 4 E/W

Distance and direction from nearest town or city street address of well if located within city? 3 W ½ N Hanover

2 WATER WELL OWNER: Russell Behrendo

RR#, St. Address, Box # : 311 S Hanover Box 386

City, State, ZIP Code : Hanover, Kansas 66945

Board of Agriculture, Division of Water Resources Application Number:

3 LOCATE WELL'S LOCATION WITH AN "X" IN SECTION BOX:

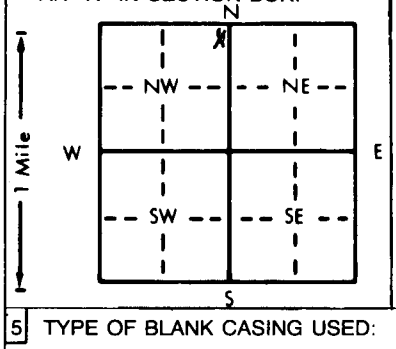

4 DEPTH OF COMPLETED WELL 70 ft. ELEVATION: ≈1340

Depth(s) Groundwater Encountered 1. NA ft. 2. ft. 3. ft.

WELL'S STATIC WATER LEVEL 52 ft. below land surface measured on mo/day/yr 7-5-1989

Pump test data: Well water was ft. after hours pumping gpm

Est. Yield 30 gpm: Well water was ft. after hours pumping gpm

Bore Hole Diameter 8 in. to 70' ft., and in. to ft.

WELL WATER TO BE USED AS: 1 Domestic X | 2 Irrigation | 3 Feedlot | 4 Industrial | 5 Public water supply | 6 Oil field water supply | 7 Lawn and garden only | 8 Air conditioning | 9 Dewatering | 10 Monitoring well | 11 Injection well | 12 Other (Specify below)

Was a chemical/bacteriological sample submitted to Department? Yes No X; If yes, mo/day/yr sample was submitted Water Well Disinfected? Yes X No

5 TYPE OF BLANK CASING USED: 1 Steel | 2 PVC X | 3 RMP (SR) | 4 ABS | 5 Wrought iron | 6 Asbestos-Cement | 7 Fiberglass | 8 Concrete tile | 9 Other (specify below)

CASING JOINTS: Glued X Clamped Welded Threaded

Blank casing diameter 5 in. to ft., Dia in. to ft., Dia in. to ft.

Casing height above land surface 24 in., weight 200 lbs./ft. Wall thickness or gauge No.

TYPE OF SCREEN OR PERFORATION MATERIAL: 1 Steel | 2 Brass | 3 Stainless steel | 4 Galvanized steel | 5 Fiberglass | 6 Concrete tile | 7 PVC X | 8 RMP (SR) | 9 ABS | 10 Asbestos-cement | 11 Other (specify) | 12 None used (open hole)

SCREEN OR PERFORATION OPENINGS ARE: 1 Continuous slot | 2 Louvered shutter | 3 Mill slot | 4 Key punched | 5 Gauzed wrapped | 6 Wire wrapped | 7 Torch cut | 8 Saw cut X | 9 Drilled holes | 10 Other (specify) | 11 None (open hole)

SCREEN-PERFORATED INTERVALS: From 50 ft. to 70 ft., From ft. to ft.

From ft. to ft., From ft. to ft.

GRAVEL PACK INTERVALS: From 20 ft. to 70 ft., From ft. to ft.

From ft. to ft., From ft. to ft.

6 GROUT MATERIAL: 1 Neat cement | 2 Cement grout | 3 Bentonite X | 4 Other

Grout Intervals: From 0 ft. to 20 ft., From ft. to ft., From ft. to ft.

What is the nearest source of possible contamination: 1 Septic tank | ✓2 Sewer lines | 3 Watertight sewer lines | 4 Lateral lines | 5 Cess pool | 6 Seepage pit | 7 Pit privy | 8 Sewage lagoon | 9 Feedyard | 10 Livestock pens | 11 Fuel storage | 12 Fertilizer storage | 13 Insecticide storage | 14 Abandoned water well | 15 Oil well/Gas well | 16 Other (specify below)

Direction from well? N How many feet? 150'

FROM	TO	LITHOLOGIC LOG	FROM	TO	PLUGGING INTERVALS
0	2	Top soil			
2	5	Yellow shale + Limestone			
5	10	gray shale			
10	15	limestone			
15	39	gray shale			
39	59	Red shale			
59	61	Tan shale			
61	64	limestone			
64	70	gray shale			

7 CONTRACTOR'S OR LANDOWNER'S CERTIFICATION: This water well was (1) constructed, (2) reconstructed, or (3) plugged under my jurisdiction and was completed on (mo/day/year) 7-5-1989 and this record is true to the best of my knowledge and belief. Kansas Water Well Contractor's License No. 2340 This Water Well Record was completed on (mo/day/yr) 10/4/89 under the business name of Strader's Blue Valley Drilling by (signature)

INSTRUCTIONS: Use typewriter or ball point pen. *PLEASE PRESS FIRMLY* and *PRINT* clearly. Please fill in blanks, underline or circle the correct answers. Send top three copies to Kansas Department of Health and Environment, Bureau of Water Protection, Topeka, Kansas 66620-7320. Telephone: 913-296-5514. Send one to WATER WELL OWNER and retain one for your records.

OFFICE USE ONLY T R E/W SEC. ¼ ¼ ¼