


1	LOCATION OF WATER WELL:	Fraction	Section Number	Township Number	Range Number
County:	Washington	SW 1/4 NE 1/4 NE 1/4	5	1	5

Distance and direction from nearest town or city street, address of well if located within city?  
 Lanham is 2 miles East of Well

2 WATER WELL OWNER: Todd Juveneman  
 RR#, St. Address, Box #: 2600 All American Road  
 City, State, ZIP Code: Hanover, KS 66945  
 Board of Agriculture, Division of Water Resources  
 Application Number:

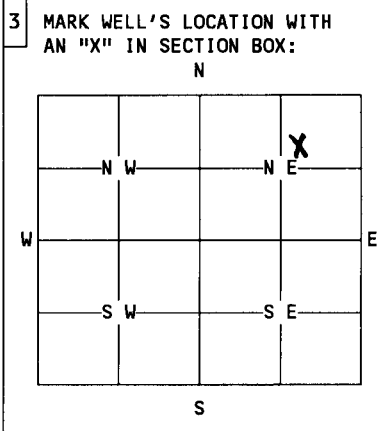

4 DEPTH OF WELL..... 60 ft.  
 WELL'S STATIC WATER LEVEL..... 0 ft. Full of Water  
 Water Was Ground Level.  
 WELL WAS USED AS:  
 1 Domestic  
 2 Irrigation  
 3 Feedlot  
 4 Industrial  
 5 Public Water Supply  
 6 Oil Field Water Supply  
 7 Lawn and Garden Only  
 8 Air Conditioning  
 9 Dewatering  
 10 Monitoring Well  
 11 Injection Well  
 12 Other: Livestock Misc.  
 Was a chemical/bacteriological sample submitted to Department? Yes....No....  
 If yes, mo/day/yr sample was submitted.....  
 Water Well Disinfected: Yes.  No.....

5 TYPE OF BLANK CASING USED:  
 1 Steel 3 RMP (SR) 5 Wrought 7 Fiberglass 9 Other (specify below)  
 2 PVC 4 ABS 6 Asbestos-Cement 8 Concrete Tile  
 Blank casing diameter... 36 in. Was casing pulled? Yes... No..... If yes, how much... 6'  
 Casing height above or below land surface... 72 in. Knocked 10' Rock Lining

6 GROUT PLUG MATERIAL: 1 Neat cement 2 Cement grout 3 Bentonite 4 Other.....  
 Grout Plug Intervals: From... 5 ft. to... 4 1/2 ft., From.....ft. to .....ft., From..... to.....ft.  
 What is the nearest source of possible contamination:  
 1 Septic tank 6 Seepage pit 11 Fuel storage 16 Other (specify below)  
 2 Sewer lines 7 Pit privy 12 Fertilizer storage  
 3 Watertight sewer lines 8 Sewage lagoon 13 Insecticide storage  
 4 Lateral lines 9 Feedyard 14 Abandoned water well  
 5 Cess Pool 10 Livestock pens 15 Oil well/Gas well  
 Direction from well? East How many feet? 10'

FROM	TO	PLUGGING MATERIALS
0	4.5	Topsoil
4.5	5.0	Bentonite Plug
5.0	60.0	Chlorinated Sand

7 CONTRACTOR'S OR LANDOWNER'S CERTIFICATION: This water well was plugged under my jurisdiction and was completed on (mo/day/year)... 12/21/98... and this record is true to the best of my knowledge and belief. Kansas Water Well Contractor's License No. NA This Water Well Record was completed on (mo/day/year) 12/21/98 under the business name of Todd Juveneman Water Service by (signature) [Signature] , WA Coordinator

INSTRUCTIONS: Use typewriter or ball point pen. Please press firmly and print clearly. Please fill in blanks, underline or circle the correct answers. Send top three copies to Kansas Department of Health and Environment, Bureau of Water, Topeka, Kansas 66620-0001. Telephone: 913/296-3565. Send one to Water Well Owner and retain one for your records.