

CORRECTION TO WATER WELL RECORD (WWC-5)

The following correction(s) was made to the attached WWC-5 log, in order to file the item or to rectify lacking or incorrect information.

Fraction (1/4 1/4 1/4) Section-Township-Range changed:

listed as 13-1-5

changed to SW SE SW, 13-15-5E

Other changes: Initial statements: _____

Changed to: _____

Comments: _____


verification method: Legal & written description, position on plat map,
and Hanover East 1:24,000 topo. map. initials: DR date: 9/6/2000

submitted by: Kansas Geological Survey, Data Resources Library, 1930 Constant Ave., Lawrence, KS 66047-3726
to: Kansas Dept of Health & Environment Bureau of Water Industrial Programs, Bldg 283, Forbes Field, KS 66620

1 LOCATION OF WATER WELL:	Fraction	Section Number	Township Number	Range Number
County: <u>Washington</u>	<u>1/4 1/4 1/4</u>	<u>13</u>	<u>1</u>	<u>5</u>

Distance and direction from nearest town or city street address of well if located within city?
5 miles North and 2 east of Hanover

2 WATER WELL OWNER: Joseph Habr
 RR#, St. Address, Box #: 2458 All American Rd Board of Agriculture, Division of Water Resources
 City, State, ZIP Code: Hanover, Ks 660945 Application Number:

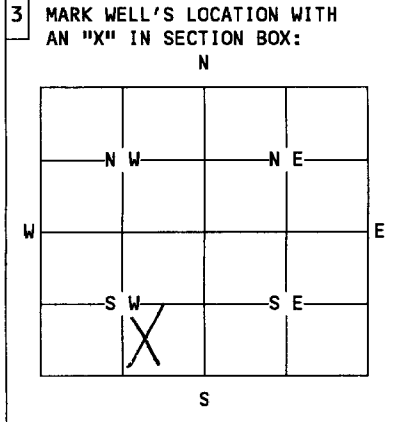

4 DEPTH OF WELL.....40.....ft.
 WELL'S STATIC WATER LEVEL...2.8.....ft. to H₂O
 WELL WAS USED AS:
 1 Domestic 5 Public Water Supply 9 Dewatering
 2 Irrigation 6 Oil Field Water Supply 10 Monitoring Well
 3 Feedlot 7 Lawn and Garden Only 11 Injection Well
 4 Industrial 8 Air Conditioning 12 Other.....
 Was a chemical/bacteriological sample submitted to Department? Yes.....No...
 If yes, mo/day/yr sample was submitted.....
 Water Well Disinfected: Yes... No.....

5 TYPE OF BLANK CASING USED:

1 Steel	3 RMP (SR)	5 Wrought	7 Fiberglass	9 Other (specify below)
2 PVC	4 ABS	6 Asbestos-Cement	8 Concrete Tile	<u>Rock Lining</u>

Blank casing diameter...4.0...in. Was casing pulled? Yes... No..... If yes, how much...5'
 Casing height above or below land surface...6.0...in.

6 GROUT PLUG MATERIAL: 1 Neat cement 2 Cement grout 3 Bentonite 4 Other.....
 Grout Plug Intervals: From 4.5.ft. to 5.0.ft., From.....ft. toft., From..... to.....ft.
 What is the nearest source of possible contamination:

1 Septic tank	6 Seepage pit	11 Fuel storage	16 Other (specify below)
2 Sewer lines	7 Pit privy	12 Fertilizer storage	<u>pasture</u>
3 Watertight sewer lines	8 Sewage lagoon	13 Insecticide storage	
4 Lateral lines	9 Feedyard	14 Abandoned water well	
5 Cess Pool	10 Livestock pens	15 Oil well/Gas well	

 Direction from well? all sides..... How many feet? immediately

FROM	TO	PLUGGING MATERIALS
<u>0</u>	<u>4.5</u>	<u>Topsoil</u>
<u>4.5</u>	<u>5.0</u>	<u>Bentonite Plug</u>
<u>5.0</u>	<u>28</u>	<u>Clay Soil</u>
<u>28</u>	<u>40</u>	<u>Chlorinated Sand</u>

7 CONTRACTOR'S OR LANDOWNER'S CERTIFICATION: This water well was plugged under my jurisdiction and was completed on (mo/day/year)....6-8-00.... and this record is true to the best of my knowledge and belief. Kansas Water Well Contractor's License No.NA..... This Water Well Record was completed on (mo/day/year)....6-8-00.... under the business name of Washington Co. Conservation District by (signature) ...Nina Meyer, NPS Coordinator.....

INSTRUCTIONS: Use typewriter or ball point pen. Please press firmly and print clearly. Please fill in blanks, underline or circle the correct answers. Send top three copies to Kansas Department of Health and Environment, Bureau of Water, Topeka, Kansas 66620-0001. Telephone: 913/296-3565. Send one to Water Well Owner and retain one for your records.