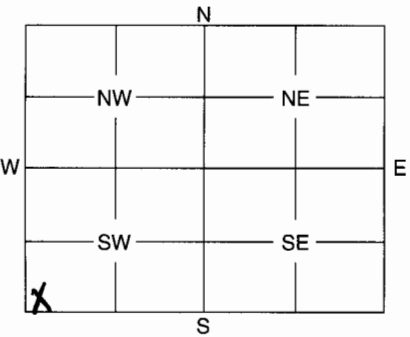


1	LOCATION OF WATER WELL:	Fraction	Section Number	Township Number	Range Number
	County: <u>Washington</u>	<u>SW 1/4 SW 1/4 SW 1/4</u>	<u>2</u>	<u>1</u>	<u>5</u> (E/W)

Distance and direction from nearest town or city street address of well if located within city?
6 1/2 miles north & 1 mile east of Hanover

2	WATER WELL OWNER: <u>Myron Lohse</u>	Board of Agriculture, Division of Water Resources
	RR #, St. Address, Box #: <u>2795 Cross Creek Road</u>	Application Number:
	City, State, ZIP Code: <u>Hanover, KS 66094</u>	

3	4	MARK WELL'S LOCATION WITH AN "X" IN SECTION BOX: 	DEPTH OF WELL <u>25</u> ft. WELL'S STATIC WATER LEVEL <u>10</u> ft. WELL WAS USED AS: 1 Domestic 5 Public Water Supply 9 Dewatering 2 Irrigation 6 Oil Field Water Supply 10 Monitoring Well 3 Feedlot 7 Domestic (Lawn & Garden) 11 Injection Well 4 Industrial 8 Air Conditioning 12 Other Was a chemical / bacteriological sample submitted to Department? Yes No If yes, mo/day/yr sample was submitted Water Well Disinfected: Yes <input checked="" type="checkbox"/> No
---	---	--	---

5	TYPE OF BLANK CASING USED:
	1 Steel 3 RMP (SR) 5 Wrought 7 Fiberglass 9 Other (Specify below) 2 PVC 4 ABS 6 Asbestos-Cement 8 Concrete Tile <u>Royal Concrete</u>
	Blank casing diameter in. Was casing pulled? Yes No If yes, how much in.

6	GROUT PLUG MATERIAL:
	1 Neat cement 2 Cement grout 3 Bentonite 4 Other Grout Plug Intervals: From <u>4.5</u> ft. to <u>5</u> ft., From ft. to ft., From to ft.
	What is the nearest source of possible contamination: 1 Septic tank 6 Seepage pit 11 Fuel storage 16 Other (specify below) 2 Sewer lines 7 Pit privy 12 Fertilizer storage 3 Watertight sewer lines 8 Sewage lagoon 13 Insecticide storage 4 Lateral lines 9 Feedyard 14 Abandoned water well 5 Cess pool 10 Livestock pens 15 Oil well/Gas well
	Direction from well? How many feet?

FROM	TO	PLUGGING MATERIALS
<u>0</u>	<u>4.5A</u>	<u>topsoil</u>
<u>4.5 ft</u>	<u>5 ft</u>	<u>Bentonite Plug</u>
<u>5 ft</u>	<u>15 ft.</u>	<u>Subsoil Fill</u>
<u>15 ft</u>	<u>25 ft.</u>	<u>Chlorinated Sand</u>

7	CONTRACTOR'S OF LANDOWNER'S CERTIFICATION: This water well was plugged under my jurisdiction and was completed on (mo/day/year) and this record is true to the best of my knowledge and belief. Kansas Water Well Contractor's License No. This Water Well Record was completed on (mo/day/year) <u>10-6-06</u> under the business name of by (signature) <u>Myron Lohse</u>
---	---

INSTRUCTIONS: Use typewriter or ball point pen. Please press firmly and print clearly. Please fill in blanks, underline or circle the correct answers. Send top three copies to Kansas Department of Health and Environment, Bureau of Water, Geology Section, 1000 SW Jackson St., Ste. 420, Topeka, Kansas 66612-1367. Telephone: 785/296-5522. Send one to Water Well Owner and retain one for your records.