


USE TYPEWRITER OR BALL POINT PEN-PRESS FIRMLY, PRINT CLEARLY.

WATER WELL RECORD
KSA 82a-1201-1215

Kansas Department of Health and Environment-Division of Environment
(Water well Contractors)
Topeka, Kansas 66620

Location of well: County Washington Fraction SE 1/4 SE 1/4 SE 1/4 Section number 5 Township number T 1 S R 5 E Range number 5

Distance and direction from nearest town or city: 1 West 1/2 South Lanham 3. Owner of well: Melvin Schramm
R.R. or street: R.R. City, state, zip code: Adell, Nebraska 68415

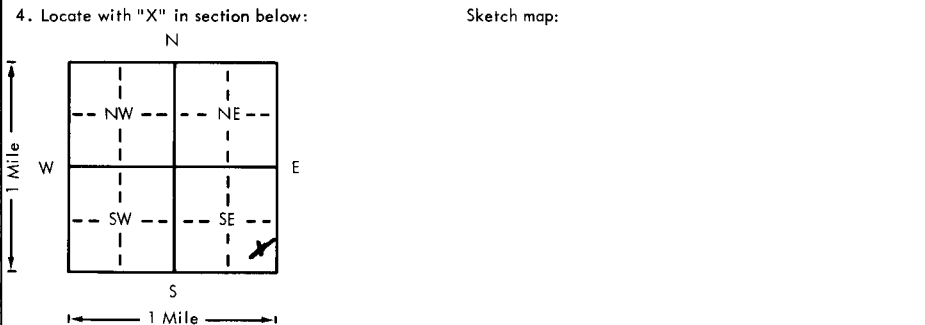

6. Bore hole dia. 30 in. Completion date 3-1-29
Well depth 75 ft.

7. Cable tool Rotary Driven Dug
 Hollow rod Jetted Bored Reverse rotary

8. Use: Domestic Public supply Industry
 Irrigation Air conditioning Stock
 Lawn Oil field water Other

Casing: Material Steel Height: Above or below
Threaded Welded Surface 12 in.
RMP PVC Weight _____ lbs./ft.
Dia. 1 1/2 in. to 25 ft. depth Wall Thickness: inches or
Dia. _____ in. to _____ ft. depth gage No. 100

5. Type and color of material	From	To
<u>soil top</u>	<u>0</u>	<u>2</u>
<u>clay Red</u>	<u>2</u>	<u>32</u>
<u>Sand</u>	<u>32</u>	<u>35</u>
<u>Sand fine</u>	<u>35</u>	<u>39</u>
<u>Sand medium</u>	<u>39</u>	<u>44</u>
<u>sandstone med hard</u>	<u>44</u>	<u>50</u>
<u>sandstone soft light colored</u>	<u>50</u>	<u>55</u>
<u>sandstone Dark yellow</u>	<u>55</u>	<u>58</u>
<u>crusty Iron rock + hard sandstone</u>	<u>58</u>	<u>60</u>
<u>Sandstone med Hard</u>	<u>60</u>	<u>73</u>
<u>Rock Iron + Clay</u>	<u>73</u>	<u>74</u>

Screen: Manufacturer's name _____

Type Transite Dia. _____
Slot/gauze 100 Length 26
Set between 49 ft. and 75 ft.
_____ ft. and _____ ft.

Gravel pack? yes Size range of material: 1/2" to 1/4"

11. Static water level: _____ mo./day/yr.
20 ft. below land surface Date _____

12. Pumping level below land surfaces:
_____ ft. after _____ hrs. pumping _____ g.p.m.
_____ ft. after _____ hrs. pumping _____ g.p.m.
Estimated maximum yield 200 g.p.m.

13. Water sample submitted: _____ mo./day/yr.
Yes _____ No _____ Date _____

Well head completion:
 Pitless adapter _____ Inches above grade

15. Well grouted? yes
With: Neat cement Bentonite Concrete
Depth: From 6 ft. to 20 ft.

Nearest source of possible contamination: None
ft. _____ Direction _____ Type _____
Well disinfected upon completion? Yes _____ No

17. Pump: _____ Not installed
Manufacturer's name Western Bell
Model number 48-9203 HP 7 1/2 Volts 440
Length of drop pipe 20 ft. capacity _____ g.p.m.
Type: _____
 Submersible Turbine
 Jet _____ Reciprocating
 Centrifugal _____ Other

18. Elevation: 1380
Topography: Hill
 Slope
 Upland
 Valley

19. Remarks:

20. Water well contractor's certification:
This well was drilled under my jurisdiction and this report is true to the best of my knowledge and belief.
Blue Valley Drilling 2340
Business name _____ License No. _____
Address Blue Rapids, Ks 66411
Signed Small Trader Date 6-20-29
Authorized representative