


USE TYPEWRITER OR BALL POINT PEN-PRESS FIRMLY, PRINT CLEARLY.

WATER WELL RECORD
KSA 82a-1201-1215

Kansas Department of Health and Environment-Division of Environment (Water well Contractors) Topeka, Kansas 66620

1. Location of well: County Washington Fraction ~~SE 1/4~~ NE 1/4 SE 1/4 Section number 19 Township number T 1-S Range number S R 3-E E/W

2. Distance and direction from nearest town or city: Harover 3 1/2 N on 15 E 2 West 1/4 north
3. Owner of well: Fred Grefe
R.R. or street: Harover Kans
City, state, zip code:

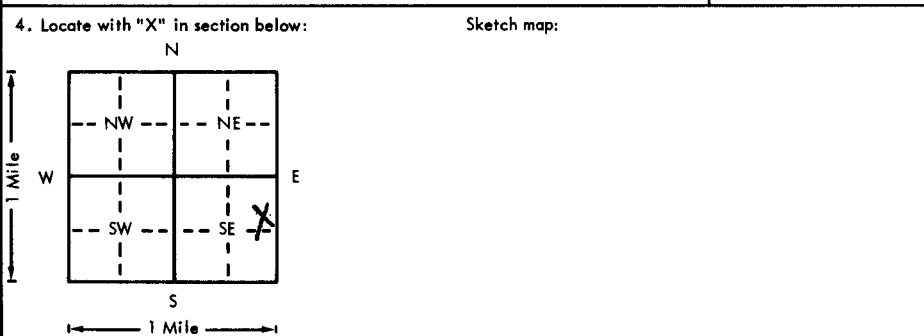

6. Bore hole dia. 6 1/2 in. Completion date 8-27-76
Well depth 68 ft.
7. Cable tool Rotary Driven Dug
 Hollow rod Jetted Bored Reverse rotary
8. Use: Domestic Public supply Industry
 Irrigation Air conditioning Stock
 Lawn Oil field water Other
9. Casing: Material Steel Height Above or below
Threaded Welded Surface 14 in.
RMP PVC Weight 20 lbs./ft.
Dia. 6 1/2 in. to 60 ft. depth, Wall Thickness: inches or
Dia. 5 in. to 60 ft. depth, gage No. 231

5. Type and color of material

	From	To
<u>top soil</u>	<u>1</u>	<u>5</u>
<u>Clay Red</u>	<u>5</u>	<u>10</u>
<u>Sandstone soft cavity</u>	<u>10</u>	<u>62</u>
<u>Shale Blue</u>	<u>62</u>	<u>68</u>

10. Screen: Manufacturer's name Pumped
Type PVC Dia. 5
Slot/gauze 1040 Length 20
Set between 48 ft. and 68 ft.
Gravel pack? Size range of material 1/4 - 1/2
11. Static water level: 40 ft. below land surface Date 8-27-76 mo./day/yr.
12. Pumping level below land surfaces:
____ ft. after ____ hrs. pumping ____ g.p.m.
____ ft. after ____ hrs. pumping ____ g.p.m.
Estimated maximum yield 10 g.p.m.
13. Water sample submitted: ____ mo./day/yr.
Yes No Date NA
14. Well head completion: NA
____ Pitless adapter ____ Inches above grade
15. Well grouted? 1-2
With: ____ Neat cement ____ Bentonite Concrete
Depth: From 14 ft. to 2 ft.
16. Nearest source of possible contamination:
ft. 50 Direction West Type Waterway
Well disinfected upon completion? ____ Yes ____ No
17. Pump: Not installed
Manufacturer's name _____ HP _____ Volts _____
Model number _____ Length of drop pipe _____ ft. capacity _____ g.p.m.
Type:
____ Submersible _____ Turbine
____ Jet _____ Reciprocating
____ Centrifugal _____ Other

18. Elevation: 1330 ft
Topography: Hill Slope Upland Valley
19. Remarks:

20. Water well contractor's certification:
This well was drilled under my jurisdiction and this report is true to the best of my knowledge and belief.
Strader Drilling Co 237
Business name License No.
Address Blue Rapids
Signed Harold Strader 8-27-76 Date
Authorized representative

T 1-S R 3-E Sec 19