

USE TYPEWRITER OR BALL POINT PEN—PRESS FIRMLY, PRINT CLEARLY.


WATER WELL RECORD
KSA 82a-1201-1215

Kansas Department of Health and Environment—Division of Environment
(Water well Contractors)
Topeka, Kansas 66620

SE 1/4 of NE 1/4 of SW 1/4

1. Location of well: County **MARSHALL** Fraction ~~SE 1/4 NW 1/4~~ **1/4** Section number **35** Township number **13 South** Range number **6 EAST** E/W

2. Distance and direction from nearest town or city: **1 1/2 MILES NORTH**
Street address of well location if in city: **1/2 MILE WEST HERKIMER, NORTH SIDE ROAD**
3. Owner of well: **ROY DIERKING**
R.R. or street: **RR 1**
City, state, zip code: **HERKIMER, KANSAS 66433**

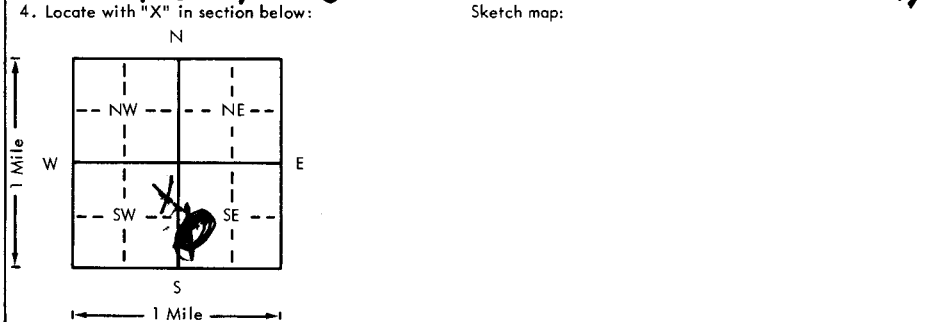

6. Bore hole dia. **5 1/4** in. Completion date **7-23-77**
Well depth **61** ft.
7. Cable tool Rotary Driven Dug
 Hollow rod Jetted Bored Reverse rotary
8. Use: Domestic Public supply Industry Irrigation Air conditioning Stock Lawn Oil field water Other
9. Casing: Material **steel** Height: Above or below
Threaded Welded Surface **18** in.
RMP PVC Weight **24** lbs./ft.
Dia. **5 1/2** in. to **53** ft. depth, Wall thickness **1/8** in.
Dia. **5 1/2** in. to **53** ft. depth, gage No. **STAP**

5. Type and color of material	From	To
TOP SOIL BLACK	0	10
CLAY RED	10	22
ROCK YELLOW	22	26
CLAY BROWN	26	40
CLAY BLUE	40	49
QUICK SAND BLUE	49	52
SHALE BLUE	52	61

10. Screen: Manufacturer's name **MPI PUMPCO**
Type **styrene** Dia. **5 1/2** in.
Slot/gauze **.025** Length **1 1/2** ft.
Set between **61** ft. and **47** ft.
Gravel pack? **yes** Size range of material **.030**
11. Static water level: **22** ft. below land surface Date **JULY 23 1977** mo./day/yr.
12. Pumping level below land surfaces: **BUCKETED**
ft. after _____ hrs. pumping _____ g.p.m.
ft. after _____ hrs. pumping _____ g.p.m.
Estimated maximum yield **30** g.p.m.
13. Water sample submitted: Yes No Date _____ mo./day/yr.
14. Well head completion: **NA** Pitless adapter _____ Inches above grade
15. Well grouted? **yes**
With: Neat cement Bentonite Concrete
Depth: From **15** ft. to **5** ft.
16. Nearest source of possible contamination: **100** ft. Direction **NE** Type **septic**
Well disinfected upon completion? Yes No
17. Pump: Not installed
Manufacturer's name _____
Model number _____ HP _____ Volts _____
Length of drop pipe _____ ft. capacity _____ g.p.m.
Type: Submersible Turbine Jet Reciprocating Centrifugal Other

18. Elevation: **RIDGE**
Topography: Hill Slope Upland Valley
19. Remarks:

20. Water well contractor's certification:
This well was drilled under my jurisdiction and this report is true to the best of my knowledge and belief.
Strader Drilling Co.
Business name **Blue Rapids** License No. _____
Address _____
Signed **Harold Strader** Date **7-23-77**
Authorized representative

1-60-35-1/4-NE 1/4 SW