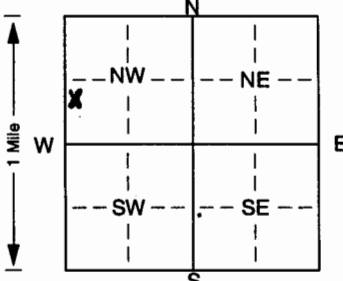


1 LOCATION OF WATER WELL: Fraction NW 1/4 SW 1/4 NW 1/4 Section Number 5 Township Number T 1 S R 6 Range Number 6 EN

Distance and direction from nearest town or city street address of well if located within city?
5 miles north of Hanover -

2 WATER WELL OWNER: Tom Zarybnicky
 RR#, St. Address, Box #: 51004 SW 61st Board of Agriculture, Division of Water Resources
 City, State, ZIP Code: Odell NE 68415 Application Number:

3 LOCATE WELL'S LOCATION WITH AN "X" IN SECTION BOX:

 4 DEPTH OF COMPLETED WELL: 55 ft. ELEVATION:
 Depth(s) Groundwater Encountered: 1. 1 ft. 2. 3.5 ft. 3. 9-27-06 ft.
 WELL'S STATIC WATER LEVEL: 3.5 ft. below land surface measured on mo/day/yr
 Pump test data: Well water was 7 ft. after 10 hours pumping 5.5 gpm
 Est. Yield: 7 gpm; Well water was 10 ft. after 5.5 hours pumping 5.5 gpm
 Bore Hole Diameter: 10 in. to 5.5 ft., and 5.5 in. to 5.5 ft.
 WELL WATER TO BE USED AS:
 5 Public water supply 8 Air conditioning 11 Injection well
 1 Domestic 3 Feedlot 6 Oil field water supply 9 Dewatering 12 Other (Specify below)
 2 Irrigation 4 Industrial 7 Domestic (lawn & garden) 10 Monitoring well Livestock
 Was a chemical/bacteriological sample submitted to Department? Yes. X No. X; If yes, mo/day/yr sample was submitted
 Water Well Disinfected? Yes No

5 TYPE OF BLANK CASING USED:
 1 Steel 3 RMP (SR) 5 Wrought iron 8 Concrete tile CASING JOINTS: Glued X Clamped
 2 PVC 4 ABS 6 Asbestos-Cement 9 Other (specify below) Welded
 7 Fiberglass Threaded
 Blank casing diameter: 5 in. to 3.5 ft., Dia. 18 in. to 2.893 lbs./ft. Wall thickness or gauge No. 26.5
 Casing height above land surface: 18 in., weight 2.893 lbs./ft. Wall thickness or gauge No. 26.5
 TYPE OF SCREEN OR PERFORATION MATERIAL:
 1 Steel 3 Stainless steel 5 Fiberglass 8 RMP (SR) 10 Asbestos-cement
 2 Brass 4 Galvanized steel 6 Concrete tile 9 ABS 11 Other (specify) 12 None used (open hole)
 SCREEN OR PERFORATION OPENINGS ARE:
 1 Continuous slot 3 Mill slot 5 Gauzed wrapped 8 Saw cut 11 None (open hole)
 2 Louvered shutter 4 Key punched 6 Wire wrapped 9 Drilled holes
 7 Torch cut 10 Other (specify) ft.
 SCREEN-PERFORATED INTERVALS: From 3.5 ft. to 55 ft., From 3.5 ft. to 55 ft.
 GRAVEL PACK INTERVALS: From 13 ft. to 55 ft., From 13 ft. to 55 ft.

6 GROUT MATERIAL: 1 Neat cement 2 Cement grout 3 Bentonite 4 Other
 Grout Intervals: From 3 ft. to 13 ft., From 3 ft. to 13 ft., From 3 ft. to 13 ft., From 3 ft. to 13 ft.
 What is the nearest source of possible contamination: None
 1 Septic tank 4 Lateral lines 7 Pit privy 10 Livestock pens 14 Abandoned water well
 2 Sewer lines 5 Cess pool 8 Sewage lagoon 11 Fuel storage 15 Oil well/Gas well
 3 Watertight sewer lines 6 Seepage pit 9 Feedyard 12 Fertilizer storage 16 Other (specify below)
 13 Insecticide storage
 Direction from well? How many feet?

FROM	TO	LITHOLOGIC LOG	FROM	TO	SCREENING INTERVALS
0	5	Top Soil	5	20	Light Gray Clay - Soft
20	25	Dark Gray Clay - Soft	25	30	Very Dark Gray Clay - Soft
30	39	Light Gray Clay - Soft	39	45	Baby Blue River Rock w/ some Gravel
4.5	47	Red Fire Clay - Hard	47	50	Light Gray Shale - Hard
50	52	Red Fire Clay - Hard	52	55	Hard White Limestone - Very Hard

7 CONTRACTOR'S OR LANDOWNER'S CERTIFICATION: This water well was (1) constructed, (2) reconstructed, or (3) plugged under my jurisdiction and was completed on (mo/day/year) 9-26-2006 and this record is true to the best of my knowledge and belief. Kansas Water Well Contractor's Licence No. 480 This Water Well Record was completed on (mo/day/yr) 10-2-06 under the business name of Williams Drilling Co Inc by (signature) Ron Williams