


1 LOCATION OF WATER WELL: County: **Marshall** Fraction: **SW 1/4 SW 1/4 NW 1/4** Section Number: **36** Township Number: **T 1 S** Range Number: **R 7 EW**

Distance and direction from nearest town or city street address of well if located within city?  
**5 N Of Club 36 E s r**

2 WATER WELL OWNER: **Laverne Kraus**  
 RR#, St. Address, Box #: **R.R.2**  
 City, State, ZIP Code: **Marysville, Kansas. 66508**  
 Board of Agriculture, Division of Water Resources  
 Application Number:

3 LOCATE WELL'S LOCATION WITH AN "X" IN SECTION BOX:

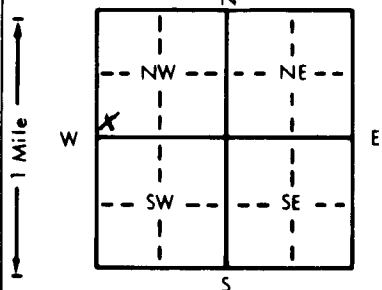

4 DEPTH OF COMPLETED WELL: **70** ft. ELEVATION:

Depth(s) Groundwater Encountered 1. .... ft. 2. .... ft. 3. .... ft.  
 WELL'S STATIC WATER LEVEL: **30** ft. below land surface measured on mo/day/yr **4-6-1989**  
 Pump test data: Well water was ..... ft. after ..... hours pumping ..... gpm  
 Est. Yield **7** gpm: Well water was ..... ft. after ..... hours pumping ..... gpm  
 Bore Hole Diameter: **9** in. to **max 70** ft., and ..... in. to ..... ft.  
 WELL WATER TO BE USED AS:  
 1 Domestic  3 Feedlot 6 Oil field water supply 9 Dewatering 12 Other (Specify below)  
 2 Irrigation 4 Industrial 7 Lawn and garden only 10 Monitoring well  
 Was a chemical/bacteriological sample submitted to Department? Yes..... No ; If yes, mo/day/yr sample was sub-  
 mitted Water Well Disinfected? Yes  No

5 TYPE OF BLANK CASING USED:  
 1 Steel 3 RMP (SR) 5 Wrought iron 8 Concrete tile CASING JOINTS: Glued  Clamped .....  
 2 PVC  4 ABS 6 Asbestos-Cement 9 Other (specify below) Welded .....  
 7 Fiberglass Threaded .....

Blank casing diameter: **5** in. to **36** ft., Dia. .... in. to ..... ft., Dia. .... in. to ..... ft.  
 Casing height above land surface: **20** in., weight **200** lbs./ft. Wall thickness or gauge No. ....

TYPE OF SCREEN OR PERFORATION MATERIAL:  
 1 Steel 3 Stainless steel 5 Fiberglass 7 PVC  10 Asbestos-cement  
 2 Brass 4 Galvanized steel 6 Concrete tile 8 RMP (SR) 11 Other (specify) .....  
 9 ABS 12 None used (open hole)

SCREEN OR PERFORATION OPENINGS ARE:  
 1 Continuous slot  3 Mill slot 5 Gauzed wrapped 8 Saw cut  11 None (open hole)  
 2 Louvered shutter 4 Key punched 6 Wire wrapped 9 Drilled holes  
 7 Torch cut 10 Other (specify) .....

SCREEN-PERFORATED INTERVALS: From **36** ft. to **66** ft., From ..... ft. to ..... ft.  
 From ..... ft. to ..... ft., From ..... ft. to ..... ft.  
 GRAVEL PACK INTERVALS: From **20** ft. to **66** ft., From ..... ft. to ..... ft.  
 From ..... ft. to ..... ft., From ..... ft. to ..... ft.

6 GROUT MATERIAL: 1 Neat cement 2 Cement grout 3 Bentonite  4 Other .....  
 Grout Intervals: From **0** ft. to **20** ft., From ..... ft. to ..... ft., From ..... ft. to ..... ft.

What is the nearest source of possible contamination:  
 1 Septic tank 4 Lateral lines 7 Pit privy 10 Livestock pens 14 Abandoned water well  
 2 Sewer lines 5 Cess pool 8 Sewage lagoon 11 Fuel storage 15 Oil well/Gas well  
 3 Watertight sewer lines 6 Seepage pit 9 Feedyard 12 Fertilizer storage 16 Other (specify below)  
 13 Insecticide storage  
 Direction from well? **East** How many feet? **20**

FROM	TO	LITHOLOGIC LOG	FROM	TO	PLUGGING INTERVALS
0	2	top soil			
2	11	Brown clay			
11	29	tan shale			
29	38	Gray Shale			
38	42	red shale			
42	54	limestone			
54	70	gray shale			

7 CONTRACTOR'S OR LANDOWNER'S CERTIFICATION: This water well was **(1)** constructed, (2) reconstructed, or (3) plugged under my jurisdiction and was completed on (mo/day/year) **4-6-1989** and this record is true to the best of my knowledge and belief. Kansas Water Well Contractor's License No. **234** This Water Well Record was completed on (mo/day/yr) **7-21-1989** under the business name of **Blue Valley Drilling** by (signature) *Betty Jo Strader*