USE TYPEWRITER OR BALL POINT PEN-PRESS FIRMLY, PRINT CLEARLY.

WATER WELL RECORD
KSA 82a-1201-1215

Kansas Department of Health and Environment-Division of Environment
(Water well Contractors)
Topeka, Kansas 66620

1. Location of well:	County: Marshall	Fraction: X N.W. 1/4 NE 1/4 NE 1/4 NW 1/4	Section number: 6	Township number: T 1 South	Range number: R 8 east E/W

2. Distance and direction from nearest town or city: O Keto 3 1/2 mi north 1/4 east 3 south side in Kans
Street address of well location if in city:

3. Owner of well: Hugo Bohner
R.R. or street:
City, state, zip code: O Keto Kans

4. Locate with "X" in section below: Sketch map:

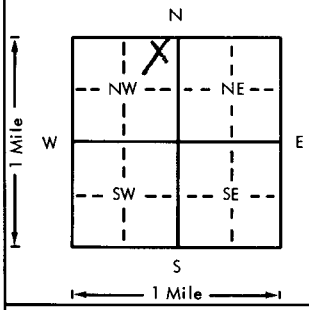

6. Bore hole dia. 10 in. Completion date 12-29-76
Well depth 140 ft.

7. X Cable tool __ Rotary __ Driven __ Dug
__ Hollow rod __ Jetted __ Bored __ Reverse rotary

8. Use: X Domestic __ Public supply __ Industry
__ Irrigation __ Air conditioning __ Stock
__ Lawn __ Oil field water __ Other

X Casing: Material PVC Height: Above or below
Threaded ___ Welded ___ Surface 15 in.
RMP ___ PVC X Weight 200 lbs./ft.
Dia. 5 in. to 140 ft. depth Wall Thickness or gauge No. .125 Wall
Dia. ___ in. to ___ ft. depth

5. Type and color of material

From	To
0	2
2	8
8	18
18	32
32	92
92	100
100	108
108	130
130	140

Type and color of material
tof Soil
Clay yellow
Sand yellow
Rock Limestone yellow
Rock Blue Hard
Shale Soft Blue
Rock Limestone
Shale Blue
Shale Red

(Use a second sheet if needed)

10. Screen: Manufacturer's name M.P.I. Pumpco
Type PVC Dia. 5
Slot/gauze 040 Length 40
Set between 90 ft. and 130 ft.
___ ft. and ___ ft.
Gravel pack? X Size range of material ~~1/8 X 1/4~~

11. Static water level: 100 ft. below land surface Date 12-29-76 mo./day/yr.

12. Pumping level below land surfaces: Baler Test
___ ft. after ___ hrs. pumping ___ g.p.m.
___ ft. after ___ hrs. pumping ___ g.p.m.
Estimated maximum yield 7 g.p.m.

13. Water sample submitted: mo./day/yr.
___ Yes X No Date NA

14. Well head completion:
___ Pitless adapter ___ \ Inches above grade

15. Well grouted? X
With: ___ Neat cement ___ Bentonite X Concrete
Depth: From 15 ft. to 4 ft.

16. Nearest source of possible contamination:
ft. 200 Direction EAST Type Barn
Well disinfected upon completion? ___ Yes ___ No

17. Pump: X Not installed
Manufacturer's name
Model number ___ HP ___ Volts ___
Length of drop pipe ___ ft. capacity ___ g.p.m.
Type:
___ Submersible ___ Turbine
___ Jet ___ Reciprocating
___ Centrifugal ___ Other

18. Elevation:

Topography:
___ Hill
___ Slope
X Upland
___ Valley

19. Remarks:

20. X Water well contractor's certification:
This well was drilled under my jurisdiction and this report is true to the best of my knowledge and belief.
Business name Strader Drilling Co License No. 237
Address Blue Rapids
Signed Harold Strader Date 12-29-76
Authorized representative

T 1 S R 8 E W Sec 6 1/4 NE NE NW 1/4

Forward the white, blue and pink copies to the Department of Health and Environment

Form WWC-5