


USE TYPEWRITER OR BALL POINT PEN-PRESS FIRMLY, PRINT CLEARLY.

WATER WELL RECORD
KSA 82a-1201-1215

Kansas Department of Health and Environment-Division of Environment
(Water well Contractors)
Topeka, Kansas 66620

1. Location of well: County Marshall Fraction NW 1/4 NE 1/4 NW 1/4 Section number 5 Township number T 5 S R 9 E W Range number

2. Distance and direction from nearest town or city: 1 north of ~~Marshall~~ 3. Owner of well: Orval Stock
Street address of well location if in city: Summerfield, Kansas R.R. or street:
City, state, zip code: Summerfield, Kansas 66541

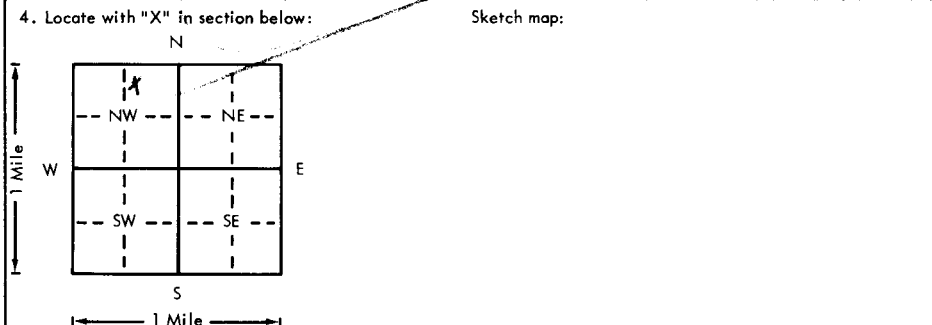

6. Bore hole dia. 8 1/2 in. Completion date 5-17-78
Well depth 83 ft.
7. Cable tool Rotary Driven Dug
 Hollow rod Jetted Bored Reverse rotary
8. Use: Domestic Public supply Industry
 Irrigation Air conditioning Stock
 Lawn Oil field water Other
 Casing: Material PVC Height: Above or below
Threaded Welded Surface 12 in.
RMP PVC Weight 200 lbs./ft.
Dia. 5 in. to 83 ft. depth Wall Thickness: inches or
Dia. 5 in. to 83 ft. depth 1/2 in. No. 200

5. Type and color of material	From	To
Soil Top	0	2
Clay Brown	2	21
Clay Tan	21	30
Clay yellow	30	40
Shale Gray	40	44
Shale Red	44	57
Stone lime softer white	57	61
Shale Blue	61	67
Rock Gray	67	68
Shale Blue	68	70
Limestone Gray + hard	70	72
Shale Blue	72	83
(Use a second sheet if needed)		

9. Screens: Manufacturer's name Plastic
NSF approved # 200
Type plastic Dia. 5
Slot/gauze .030 Length 20
Set between 55 ft. and 75 ft.
Gravel pack? Size range of material Concrete?
11. Static water level: 38 ft. below land surface Date 5-17-78 mo./day/yr.
12. Pumping level below land surfaces:
____ ft. after ____ hrs. pumping ____ g.p.m.
____ ft. after ____ hrs. pumping ____ g.p.m.
Estimated maximum yield ____ g.p.m.
13. Water sample submitted: ____ mo./day/yr.
Yes No Date ____
14. Well head completion: capped
____ Pitless adapter ____ Inches above grade
15. Well grouted? yes
With: ____ Neat cement ____ Bentonite Concrete
Depth: From 0 ft. to 20 ft.
16. Nearest source of possible contamination: none
ft. ____ Direction ____ Type ____
Well disinfected upon completion? Yes No
17. Pump: Not installed
Manufacturer's name ____
Model number ____ HP ____ Volts ____
Length of drop pipe ____ ft. capacity ____ g.p.m.
Type:
 Submersible Turbine
 Jet Reciprocating
 Centrifugal Other

18. Elevation: _____
19. Remarks: _____
Topography:
 Hill
 Slope
 Upland
 Valley

20. Water well contractor's certification:
This well was drilled under my jurisdiction and this report is true to the best of my knowledge and belief.
Blue Valley Drilling 234
Business name Blue Valley Drilling Co License No. _____
Address Blue Valley, Mo 64641
Signed Gerald Strick Date 8-30-78
Authorized representative

T-1-9-5
R-9-5
W-5
Sec 5
NW 1/4