USE TYPEWRITER OR BALL POINT PEN-PRESS FIRMLY, PRINT CLEARLY.

WATER WELL RECORD
KSA 82a-1201-1215

Kansas Department of Health and Environment-Division of Environment
(Water well Contractors)
Topeka, Kansas 66620

1. Location of well: County: Marshall | Fraction: X South east SE 1/4 NE 1/4 SE 1/4 | Section number: 18 | Township number: T 1 South S | Range number: R 9 East E/W

2. Distance and direction from nearest town or city: 7 west Home City
Street address of well location if in city: 5 north 4 east 1/4 north

3. Owner of well: Harold Schneider
R.R. or street:
City, state, zip code: Summerfield Kans

4. Locate with "X" in section below:

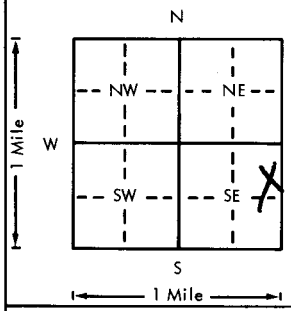

Sketch map:

6. Bore hole dia. 10 in. Completion date 3-23-77
Well depth 73 ft.

7. X Cable tool __ Rotary __ Driven __ Dug
__ Hollow rod __ Jetted __ Bored __ Reverse rotary

8. Use: X Domestic __ Public supply __ Industry
__ Irrigation __ Air conditioning __ Stock
__ Lawn __ Oil field water __ Other

9. Casing: Material PVC Height: (Above) or below
Threaded __ Welded __ Surface 12 in.
RMP __ PVC __ Weight __ lbs./ft.
Dia. 5 in. to 73 ft. depth Wall Thickness: inches or
Dia. __ in. to __ ft. depth gage No. Sch 40 ?

5. Type and color of material	From	To
Top Soil Black	1	6
Rock, Limestone with lime	6	35
Shale, Red	35	42
Rock, Very hard Blue	42	65
Rock, Limestone Water at 70'	65	73
(Use a second sheet if needed)		

10. Screen: Manufacturer's name Pumpco
Type PVC Dia. 5
Slot/gauge .040 Length 40
Set between 33 ft. and 73 ft.
__ ft. and __ ft.
Gravel pack? X Size range of material 3/8 V 4

11. Static water level: mo./day/yr.
53 ft. below land surface Date 3-23-77

12. Pumping level below land surfaces:
__ ft. after __ hrs. pumping __ g.p.m.
__ ft. after __ hrs. pumping __ g.p.m.
Estimated maximum yield 15 g.p.m.

13. Water sample submitted: mo./day/yr.
__ Yes X No Date

14. Well head completion: NA
__ Pitless adapter __ Inches above grade

15. Well grouted? X
With: __ Neat cement __ Bentonite X Concrete
Depth: From 5 ft. to 16 ft.

16. Nearest source of possible contamination:
ft. 250' Direction N. east Type Septic
Well disinfected upon completion? X Yes __ No

17. Pump: X Not installed
Manufacturer's name
Model number HP Volts
Length of drop pipe ft. capacity g.p.m.
Type:
__ Submersible __ Turbine
__ Jet __ Reciprocating
__ Centrifugal __ Other

18. Elevation:
Topography:
__ Hill
__ Slope
__ Upland
__ Valley

19. Remarks:

20. Water well contractor's certification:
This well was drilled under my jurisdiction and this report is true to the best of my knowledge and belief.
Strader Drilling Co
Business name License No.
Address Blue Rapids
Signed Harold Strader Date 3-23-77
Authorized representative

T 1 S R 9 E W Sec 18 1/4 1/4 1/4 SE

Forward the white, blue and pink copies to the Department of Health and Environment

Form WWC-5