


1 LOCATION OF WATER WELL:	Fraction	Section Number	Township Number	Range Number
County: Marion	SW 1/4 SW 1/4 SW 1/4	34	T 20 S	R 1 <del>50</del>

Distance and direction from nearest town or city street address of well if located within city?  
 1 mile North & 1 mile East of Goessell, KS

2 WATER WELL OWNER: John Craft  
 RR#, St. Address, Box # : RR 2, Box 71A Board of Agriculture, Division of Water Resources  
 City, State, ZIP Code : Hillsboro, KS 67063 Application Number:

3 LOCATE WELL'S LOCATION WITH AN "X" IN SECTION BOX:	4 DEPTH OF COMPLETED WELL: 64 ft. ELEVATION:

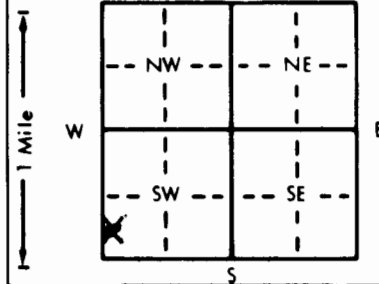

5 TYPE OF BLANK CASING USED:

1 Steel	3 RMP (SR)	6 Asbestos-Cement	9 Other (specify below)	Welded . . . . .
<input checked="" type="checkbox"/> PVC	4 ABS	7 Fiberglass		Threaded . . . . .

Blank casing diameter . . . 5 . . . . . in. to 44 . . . . . ft., Dia . . . . . in. to . . . . . ft., Dia . . . . . in. to . . . . . ft.  
 Casing height above land surface . . . 12 . . . . . in., weight . . . 2.37 . . . . . lbs./ft. Wall thickness or gauge No. . . 214

TYPE OF SCREEN OR PERFORATION MATERIAL:

1 Steel	3 Stainless steel	5 Fiberglass	8 RMP (SR)	10 Asbestos-cement
2 Brass	4 Galvanized steel	6 Concrete tile	9 ABS	11 Other (specify) . . . . .
				12 None used (open hole)

SCREEN OR PERFORATION OPENINGS ARE:

1 Continuous slot	<input checked="" type="checkbox"/> Mill slot	5 Gauzed wrapped	8 Saw cut	11 None (open hole)
2 Louvered shutter	4 Key punched	6 Wire wrapped	9 Drilled holes	
		7 Torch cut	10 Other (specify) . . . . .	

SCREEN-PERFORATED INTERVALS: From . . . 44 . . . . . ft. to . . . 64 . . . . . ft., From . . . . . ft. to . . . . . ft.  
 From . . . . . ft. to . . . . . ft., From . . . . . ft. to . . . . . ft.  
 GRAVEL PACK INTERVALS: From . . . 20 . . . . . ft. to . . . 64 . . . . . ft., From . . . . . ft. to . . . . . ft.  
 From . . . . . ft. to . . . . . ft., From . . . . . ft. to . . . . . ft.

6 GROUT MATERIAL: 1 Neat cement  Cement grout 3 Bentonite 4 Other . . . . .

Grout Intervals: From . . . 0 . . . . . ft. to . . . 20 . . . . . ft., From . . . . . ft. to . . . . . ft., From . . . . . ft. to . . . . . ft.

What is the nearest source of possible contamination:

<input checked="" type="checkbox"/> Septic tank	4 Lateral lines	7 Pit privy	10 Livestock pens	14 Abandoned water well
2 Sewer lines	5 Cess pool	8 Sewage lagoon	11 Fuel storage	15 Oil well/Gas well
3 Watertight sewer lines	6 Seepage pit	9 Feedyard	12 Fertilizer storage	16 Other (specify below)
			13 Insecticide storage	

Direction from well? North How many feet? 80

FROM	TO	LITHOLOGIC LOG	FROM	TO	PLUGGING INTERVALS
0	2	Top Soil			
2	9	Tan Clay			
9	40	Gray Shale			
40	64	Gray Shale with some small fractureds			

7 CONTRACTOR'S OR LANDOWNER'S CERTIFICATION: This water well was (1)  constructed, (2) reconstructed, or (3) plugged under my jurisdiction and was completed on (mo/day/year) . . . 4/16/96 . . . . . and this record is true to the best of my knowledge and belief. Kansas Water Well Contractor's License No. . . . 138 . . . . . This Water Well Record was completed on (mo/day/yr) . . . 4/18/96 . . . . . under the business name of Peterson Irrigation, Inc. by (signature) Mike Peterson