USE TYPEWRITER OR BALL POINT PEN-PRESS FIRMLY, PRINT CLEARLY.

T R EW sec 1/4 1/4 1/4 No.

WATER WELL RECORD
KSA 82a-1201-1215

Kansas State Dept. Of Health
(Water Well Contractors)
Forbes-Bldg. 740
Topeka, Kansas 66620

1 Location of well:	County	Township name	Fraction	Section number	Town number	Range number
	Marion	Menno	S ~~NE~~ ¼ SE¼ NE¼	24	20-S	1-E

Distance and direction from nearest town or city: 3 Mi. South 1 West ½ South Of Hillsboro

Street address of well location if in city:

3 Owner of well: Don Fulk

Address: 6045 S. Minneapolis Wichita, Kansas 67216

Locate with "X" in section below: Sketch map:

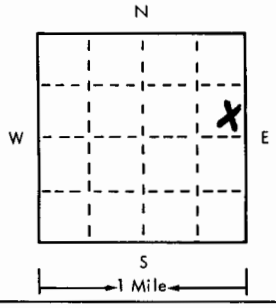

4 Well depth: 56 ft. Date of completion 4-15-75
Well diameter 9 in.

5 [X] Cable tool [ ] Rotary [ ] Driven [ ] Dug
[ ] Hollow rod [ ] Jetted [ ] Bored [ ] Reverse rotary

6 Use: [X] Domestic [ ] Public supply [ ] Industry
[ ] Irrigation [ ] Air conditioning [ ] Commercial
[ ] Test well [ ]

7 Casing: Material Plastic Height: above/below
Threaded [ ] Welded [ ] Surface 40 in.
Diam. Class 160 Weight lbs./ft.
5 in. to 56 ft. depth Drive shoe? [ ] Yes [X] No
in. to ft. depth

2

Type and color of material	From	To
Yellow Clay	0	25
Gray Clay and Shale	25	32
Water	32	34
Blue Shale	34	56
(use a second sheet if needed)		

8 Screen:
Manufacturer Certain-Teed
Type Plastic Dia. 5In.
Slot/gauze 1/8 Length 20
Set between 27 ft. and 37 ft.
Fittings: 47 56
Gravel pack [X] Yes [ ] No Size range of material 1/8 To 1/4

9 Static water level:
30 ft. below land surface Date 4-15-75

10 Pumping level below land surfaces:
ft. after hrs. pumping g.p.m.
ft. after hrs. pumping g.p.m.
Estimated maximum yield g.p.m.

11 Water sample submitted:
[ ] Yes [X] No Date

12 Well head completion:
[ ] Pitless adapter [ ] Inches above grade

13 Well grouted? [ ] Yes [ ] No
[X] Neat cement [ ] Bentonite [ ]
Depth: From 3 ft. to 13 ft.

14 Nearest source of possible contamination:
ft. 80 Direction East Type Pasture
Well disinfected upon completion? [X] Yes [ ] No

15 Pump: [X] Not installed
Manufacturer's name
Model number HP Volts
Length of drop pipe ft. capacity g.m.p.
Type:
[ ] Submersible [ ] Turbine
[ ] Jet [ ] Reciprocating
[ ] Certrifugal [ ] Other

16 Remarks: elevation

Topography:
[ ] Hill
[ ] Slope
[ ] Upland
[X] Valley

17 Water well contractor's certification:
This well was drilled under my jurisdiction and this report is true to the best of my knowledge and belief.
Backhus Drilling 180
Business name License No.
Address Tampa, Kansas
Signed Paul Backhus Date 4-15-75
Authorized representative

Forward the white, blue and pink copies to the Kansas State Dept. Of Health.

Form WWC-5

677-H