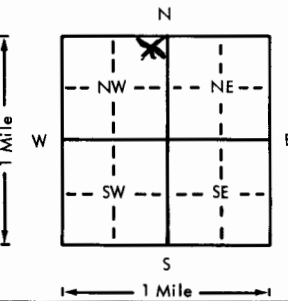


USE TYPEWRITER OR BALL POINT PEN—PRESS FIRMLY, PRINT CLEARLY.

WATER WELL RECORD
KSA 82a-1201-1215

Kansas Department of Health and Environment—Division of Environment
(Water well Contractors)
Topeka, Kansas 66620

1. Location of well: County <u>Marion</u> Fraction <u>Me 1/4 Me 1/4 Nw 1/4</u> Section number <u>33</u> Township number <u>20</u> Range number <u>1</u> EW	
2. Distance and direction from nearest town or city: <u>5 S 6 1/2 W</u> 3. Owner of well: <u>Paul Ediger</u> Street address of well location if in city: <u>Hillsboro</u> R.R. or street: City, state, zip code: <u>Hillsboro, KS</u>	
4. Locate with "X" in section below: Sketch map: 	6. Bore hole dia. <u>5</u> in. Completion date <u>8-25-77</u> Well depth <u>122</u> ft.
	7. <input checked="" type="checkbox"/> Cable tool <input type="checkbox"/> Rotary <input type="checkbox"/> Driven <input type="checkbox"/> Dug <input type="checkbox"/> Hollow rod <input type="checkbox"/> Jetted <input type="checkbox"/> Bored <input type="checkbox"/> Reverse rotary
	8. Use: <input type="checkbox"/> Domestic <input type="checkbox"/> Public supply <input checked="" type="checkbox"/> Industry <input type="checkbox"/> Irrigation <input type="checkbox"/> Air conditioning <input checked="" type="checkbox"/> Stock <input type="checkbox"/> Lawn <input type="checkbox"/> Oil field water <input type="checkbox"/> Other
	9. Casing: Material <u>PVC</u> Height: Above or below Threaded <input type="checkbox"/> Welded <input type="checkbox"/> Surface <u>1 1/2</u> in. RMP <input type="checkbox"/> PVC <input checked="" type="checkbox"/> Weight <u>60 lbs./ft.</u> Dia. <u>5</u> in. to <u>122</u> ft. depth Wall Thickness: inches or Dia. <u>5</u> in. to <u>122</u> ft. depth gage No. <u>258</u>
5. Type and color of material	10. Screen: Manufacturer's name <u>ASTM</u> Type <u>PVC</u> Dia. <u>5"</u> Slot/gauze <u>40</u> Length <u>23'</u> Set between <u>90</u> ft. and <u>100</u> ft. <u>112</u> ft. and <u>122</u> ft. Gravel pack? <input checked="" type="checkbox"/> Size range of material <u>30</u>
	11. Static water level: <u>18</u> ft. below land surface Date <u>8-25-77</u> mg./day/yr.
	12. Pumping level below land surfaces: ____ ft. after ____ hrs. pumping ____ g.p.m. ____ ft. after ____ hrs. pumping ____ g.p.m. Estimated maximum yield ____ g.p.m.
	13. Water sample submitted: ____ mo./day/yr. <input type="checkbox"/> Yes <input checked="" type="checkbox"/> No Date ____
	14. Well head completion: <u>14" Windmill</u> <input type="checkbox"/> Pitless adapter ____ Inches above grade
	15. Well grouted? <input checked="" type="checkbox"/> With: <input type="checkbox"/> Neat cement <input type="checkbox"/> Bentonite <input checked="" type="checkbox"/> Concrete Depth: From <u>0</u> ft. to <u>10</u> ft.
	16. Nearest source of possible contamination: <u>1 1/2 Pasture</u> ft. ____ Direction ____ Type ____ Well disinfected upon completion? <input type="checkbox"/> Yes <input type="checkbox"/> No
	17. Pump: <input checked="" type="checkbox"/> Not installed Manufacturer's name ____ Model number ____ HP ____ Volts ____ Length of drop pipe ____ ft. capacity ____ g.p.m. Type: <input type="checkbox"/> Submersible <input type="checkbox"/> Turbine <input type="checkbox"/> Jet <input type="checkbox"/> Reciprocating <input type="checkbox"/> Centrifugal <input type="checkbox"/> Other
18. Elevation:	20. Water well contractor's certification: This well was drilled under my jurisdiction and this report is true to the best of my knowledge and belief. <u>Barckhus Drlg. 180</u> Business name <u>Tampa, KS.</u> License No. ____ Address <u>Paul Barckhus</u> Signed <u>Paul Barckhus</u> Date <u>8-25-77</u> Authorized representative
19. Remarks: Topography: <input type="checkbox"/> Hill <input checked="" type="checkbox"/> Slope <input type="checkbox"/> Upland <input type="checkbox"/> Valley	

20-10-10-33 MEW EW
1/4 1/4 1/4

Forward the white, blue and pink copies to the Department of Health and Environment

Form WWC-5