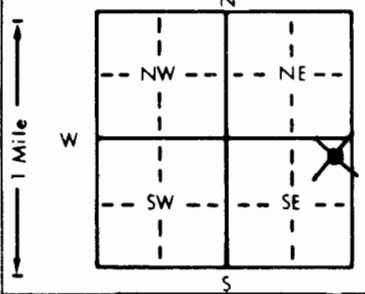


1 LOCATION OF WATER WELL: Fraction NE 1/4 NE 1/4 SE 1/4 Section Number 13 Township Number T 20 S Range Number R 1 E
 County: Marion

Distance and direction from nearest town or city street address of well if located within city?
610 N. D-In City Limits

2 WATER WELL OWNER: Howard Schmidt
 RR#, St. Address, Box # : 610 N. D Board of Agriculture, Division of Water Resources
 City, State, ZIP Code : Hillsboro, KS 67063 Application Number:

3 LOCATE WELL'S LOCATION WITH AN "X" IN SECTION BOX:  DEPTH OF COMPLETED WELL 40 ft. ELEVATION:
 Depth(s) Groundwater Encountered 1. 28 ft. 2. . ft. 3. . ft.
 WELL'S STATIC WATER LEVEL 28 ft. below land surface measured on mo/day/yr 9-15&16-94
 Pump test data: Well water was . ft. after . hours pumping . gpm
 Est. Yield 15-20 gpm: Well water was 31 ft. after 2 hours pumping 10 gpm
 Bore Hole Diameter 8 in. to 42 ft., and . in. to . ft.
 WELL WATER TO BE USED AS: 5 Public water supply 8 Air conditioning 11 Injection well
 1 Domestic 3 Feedlot 6 Oil field water supply 9 Dewatering 12 Other (Specify below)
 2 Irrigation 4 Industrial 7 Lawn and garden only 10 Monitoring well
 Was a chemical/bacteriological sample submitted to Department? Yes . No X . If yes, mo/day/yr sample was submitted
 Water Well Disinfected? Yes X No

5 TYPE OF BLANK CASING USED: 5 Wrought iron 8 Concrete tile CASING JOINTS: Glued X Clamped .
 1 Steel 3 RMP (SR) 6 Asbestos-Cement 9 Other (specify below) Welded .
2 PVC 4 ABS 7 Fiberglass Threaded.
 Blank casing diameter 5 in. to 30 ft., Dia . in. to . ft., Dia . in. to . ft.
 Casing height above land surface 12 in., weight 2.37 lbs./ft. Wall thickness or gauge No. 214
 TYPE OF SCREEN OR PERFORATION MATERIAL: 7 PVC 10 Asbestos-cement
 1 Steel 3 Stainless steel 5 Fiberglass 8 RMP (SR) 11 Other (specify) .
 2 Brass 4 Galvanized steel 6 Concrete tile 9 ABS 12 None used (open hole)
 SCREEN OR PERFORATION OPENINGS ARE: 5 Gauzed wrapped 8 Saw cut 11 None (open hole)
 1 Continuous slot 3 Mill slot 6 Wire wrapped 9 Drilled holes
 2 Louvered shutter 4 Key punched 7 Torch cut 10 Other (specify) .
 SCREEN-PERFORATED INTERVALS: From 30 ft. to 40 ft., From . ft. to . ft.
 From . ft. to . ft., From . ft. to . ft.
 GRAVEL PACK INTERVALS: From 25 ft. to 40 ft., From . ft. to . ft.
 From . ft. to . ft., From . ft. to . ft.

6 GROUT MATERIAL: 1 Neat cement 2 Cement grout) 3 Bentonite 4 Other .
 Grout Intervals: From 5 ft. to 25 ft., From . ft. to . ft., From . ft. to . ft.
 What is the nearest source of possible contamination:
 1 Septic tank 4 Lateral lines 7 Pit privy 10 Livestock pens 14 Abandoned water well
 2 Sewer lines 5 Cess pool 8 Sewage lagoon 11 Fuel storage 15 Oil well/Gas well
 3 Watertight sewer lines 6 Seepage pit 9 Feedyard 12 Fertilizer storage 16 Other (specify below)
 13 Insecticide storage

Direction from well? South How many feet? 1000ft

FROM	TO	LITHOLOGIC LOG	FROM	TO	PLUGGING INTERVALS
0	4	Top Soil			
4	18	Brown Clay			
18	26	Brwon Sandy Clay			
26	35	Loose Gray Shale			
35	37	Fractured Limestone-Vein			
37	42	Gray Shale & Limestone			

7 CONTRACTOR'S OR LANDOWNER'S CERTIFICATION: This water well was (1) constructed, (2) reconstructed, or (3) plugged under my jurisdiction and was completed on (mo/day/year) 9-16-94 and this record is true to the best of my knowledge and belief. Kansas Water Well Contractor's License No. 138 This Water Well Record was completed on (mo/day/yr) 9-27-94 under the business name of Peterson Irrigation Inc. by (signature) Mike Peters

INSTRUCTIONS: Use typewriter or ball point pen. PLEASE PRESS FIRMLY and PRINT clearly. Please fill in blanks, underline or circle the correct answers. Send top three copies to Kansas Department of Health and Environment, Bureau of Water, Topeka, Kansas 66620-0001. Telephone: 913-296-5545. Send one to WATER WELL OWNER and retain one for your records.