


1 LOCATION OF WATER WELL: Fraction NW 1/4 NW 1/4 SE 1/4 Section Number 2 Township Number T 20 S Range Number R 18 EW County: LYON

Distance and direction from nearest town or city street address of well if located within city? EMPORIA - 6th - PRARRIG ST 5 1/2 S - SW

2 WATER WELL OWNER: DULLY MAY SOYEZ RR#, St. Address, Box #: ROUTE 1 CEDAR POINT KS 66843 Board of Agriculture, Division of Water Resources Application Number:

3 LOCATE WELL'S LOCATION WITH AN "X" IN SECTION BOX:

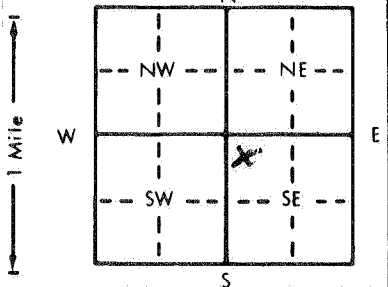

4 DEPTH OF COMPLETED WELL: 22 ft. ELEVATION: ---

Depth(s) Groundwater Encountered 1. NA ft. 2. --- ft. 3. --- ft.

WELL'S STATIC WATER LEVEL 16 ft. below land surface measured on mo/day/yr 03-06-91

Pump test data: Well water was --- ft. after --- hours pumping --- gpm

Est. Yield NA gpm: Well water was --- ft. after --- hours pumping --- gpm

Bore Hole Diameter: APPROX 22" OUTSIDE OF LIME STONE WALL ft.

WELL WATER TO BE USED AS: NA 5 Public water supply 8 Air conditioning 11 Injection well

1 Domestic 3 Feedlot 6 Oil field water supply 9 Dewatering 12 Other (Specify below)

2 Irrigation 4 Industrial 7 Lawn and garden only 10 Monitoring well

Was a chemical/bacteriological sample submitted to Department? Yes --- No X If yes, mo/day/yr sample was submitted

Water Well Disinfected? Yes X No ---

5 TYPE OF BLANK CASING USED: 5 Wrought iron 8 Concrete tile CASING JOINTS: Glued --- Clamped ---

1 Steel 3 RMP (SR) 6 Asbestos-Cement 9 Other (specify below) Welded ---

2 PVC 4 ABS 7 Fiberglass SDY LIME STONE WALL Threaded ---

Blank casing diameter --- in. to --- ft., Dia --- in. to --- ft., Dia --- in. to --- ft.

Casing height above land surface --- in., weight --- lbs./ft. Wall thickness or gauge No. ---

TYPE OF SCREEN OR PERFORATION MATERIAL: NA 7 PVC 10 Asbestos-cement

1 Steel 3 Stainless steel 5 Fiberglass 8 RMP (SR) 11 Other (specify) ---

2 Brass 4 Galvanized steel 6 Concrete tile 9 ABS 12 None used (open hole)

SCREEN OR PERFORATION OPENINGS ARE: NA 5 Gauzed wrapped 8 Saw cut 11 None (open hole)

1 Continuous slot 3 Mill slot 6 Wire wrapped 9 Drilled holes

2 Louvered shutter 4 Key punched 7 Torch cut 10 Other (specify) ---

SCREEN-PERFORATED INTERVALS: From NA ft. to --- ft., From --- ft. to --- ft.

GRAVEL PACK INTERVALS: From --- ft. to --- ft., From --- ft. to --- ft.

6 GROUT MATERIAL: 1 Neat cement 2 Cement grout 3 Bentonite 4 Other CHAY BASE - LIME STONE

Grout Intervals: From 6" 7' 10" BELOW CREEK BED ft. to --- ft., From --- ft. to --- ft.


What is the nearest source of possible contamination: NA * 10 Livestock pens 14 Abandoned water well

1 Septic tank 4 Lateral lines 7 Pit privy 11 Fuel storage 15 Oil well/Gas well

2 Sewer lines 5 Cess pool 8 Sewage lagoon 12 Fertilizer storage 16 Other (specify below)

3 Watertight sewer lines 6 Seepage pit 9 Feedyard 13 Insecticide storage CREEK

Direction from well? 1/2 OF WELL EXPOSED How many feet? SAME

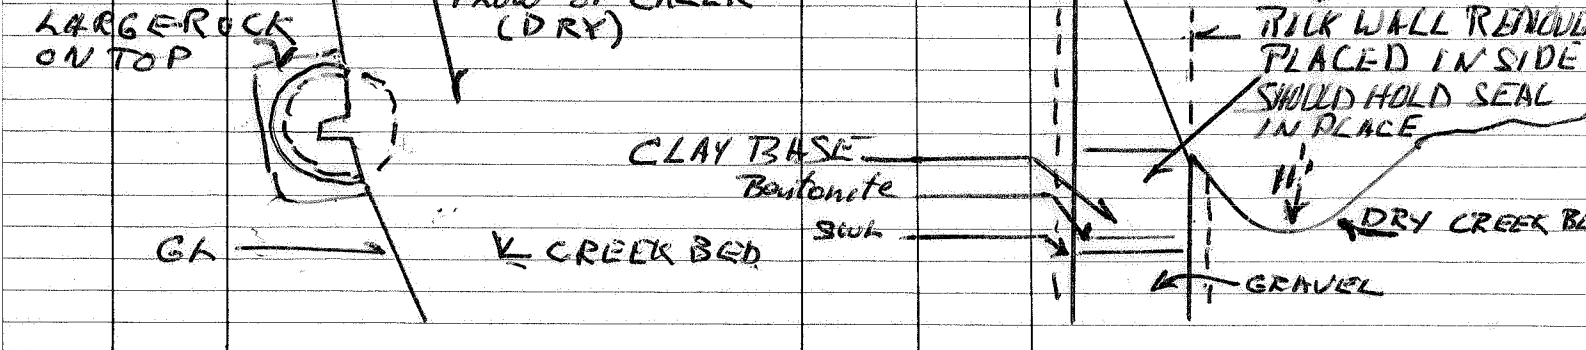

7 CONTRACTOR'S OR LANDOWNER'S CERTIFICATION: This water well was (1) constructed, (2) reconstructed, or (3) plugged under my jurisdiction and was completed on (mo/day/year) 03-07-91 and this record is true to the best of my knowledge and belief. Kansas Water Well Contractor's License No. 479 This Water Well Record was completed on (mo/day/yr) 03-02-91 under the business name of EBBERTS DRILLING by signature Megan Ebberts

INSTRUCTIONS: Use typewriter or ball point pen. PLEASE PRESS FIRMLY and PRINT clearly. Please fill in blanks, underline or circle the correct answers. Send top three copies to Kansas Department of Health and Environment, Bureau of Water, Topeka, Kansas 66620-7320. Telephone: 913-296-5545. Send one to WATER WELL OWNER and retain one for your records.