


1 LOCATION OF WATER WELL: Fraction NW 1/4 NW 1/4 SE 1/4 Section Number 2 Township Number T 20 S Range Number R 10 EW
 County: LYDN

Distance and direction from nearest town or city street address of well if located within city?

EMPORIA - 6TH + PRARREE ST - 5 1/2 S - 3W

2 WATER WELL OWNER: ODDLY MAY SOYEZ Board of Agriculture, Division of Water Resources
 RR#, St. Address, Box # TRI CEDAR POINT KS 66843 Application Number:
 City, State, ZIP Code

3 LOCATE WELL'S LOCATION WITH AN "X" IN SECTION BOX: 4 DEPTH OF COMPLETED WELL: 51 ft. ELEVATION: -
 Depth(s) Groundwater Encountered: * 17 ft. 2. > ft. 3. - ft.

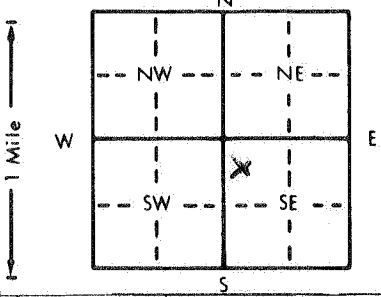

WELL'S STATIC WATER LEVEL * 20 ft. below land surface measured on mo/day/yr 03-05-91
 Pump test data: Well water was - ft. after - hours pumping - gpm
 Est. Yield * - gpm: Well water was - ft. after - hours pumping - gpm
 Bore Hole Diameter: 8 7/8 in. to 5 1/2 ft., and - in. to - ft.
 WELL WATER TO BE USED AS: NA 5 Public water supply 8 Air conditioning 11 Injection well
 1 Domestic 3 Feedlot 6 Oil field water supply 9 Dewatering 12 Other (Specify below)
 2 Irrigation 4 Industrial 7 Lawn and garden only 10 Monitoring well
 Was a chemical/bacteriological sample submitted to Department? Yes - No X; If yes, mo/day/yr sample was submitted -
 Water Well Disinfected? Yes X No -

5 TYPE OF BLANK CASING USED: NA 5 Wrought iron 8 Concrete tile CASING JOINTS: Glued - Clamped -
 1 Steel 3 RMP (SR) 6 Asbestos-Cement 9 Other (specify below) Welded -
 2 PVC 4 ABS 7 Fiberglass Threaded -

Blank casing diameter - in. to - ft., Dia - in. to - ft., Dia - in. to - ft.
 Casing height above land surface - in., weight - lbs./ft. Wall thickness or gauge No. -

TYPE OF SCREEN OR PERFORATION MATERIAL: NA 7 PVC 10 Asbestos-cement
 1 Steel 3 Stainless steel 5 Fiberglass 8 RMP (SR) 11 Other (specify) -
 2 Brass 4 Galvanized steel 6 Concrete tile 9 ABS 12 None used (open hole)

SCREEN OR PERFORATION OPENINGS ARE: NA 5 Gauzed wrapped 8 Saw cut 11 None (open hole)
 1 Continuous slot 3 Mill slot 6 Wire wrapped 9 Drilled holes
 2 Louvered shutter 4 Key punched 7 Torch cut 10 Other (specify) -

SCREEN-PERFORATED INTERVALS: From - ft. to - ft., From - ft. to - ft., From - ft. to - ft.
 GRAVEL PACK INTERVALS: From 17 ft. to 51 ft., From - ft. to - ft., From - ft. to - ft.

6 GROUT MATERIAL: 1 Neat cement 2 Cement grout 3 Bentonite 4 Other -
 Grout Intervals: From 2 ft. to 10 ft., From - ft. to - ft., From - ft. to - ft., From - ft. to - ft.

What is the nearest source of possible contamination:
 1 Septic tank 4 Lateral lines 7 Pit privy 10 Livestock pens 14 Abandoned water well
 2 Sewer lines 5 Cess pool 8 Sewage lagoon 11 Fuel storage 15 Oil well/Gas well
 3 Watertight sewer lines 6 Seepage pit 9 Feedyard 12 Fertilizer storage 16 Other (specify below)
 13 Insecticide storage

Direction from well? 3 AB.W. U - HAND DUG How many feet? APPROX. 60' NE 200' N - 360' E

FROM	TO	LITHOLOGIC LOG	FROM	TO	PLUGGING INTERVALS
0	3	TOP - SILT	*		GROUND WATER -
3	27	CLAY SILT - SMALL GRAVEL EMBEDDED			17' - 3-4 GPM - DEPLETED 48 HRS
27	42	SHALE - LT GREY - MICRO-SAND			7 DAY OPEN TEST
42	44	SAND - TIGHT - NO PERM - REF.			SWL - 20' - PUMPED OUT - RECOVERED
44	45	SANDY LIME			- 2 G AT END OF 1 HR TEST
45	51	SHALE - LT GREY T.D.			
		N			
		B			
		THIS WELL			
		HOUSE - B			

7 CONTRACTOR'S OR LANDOWNER'S CERTIFICATION: This water well was (1) constructed, (2) reconstructed, or (3) plugged under my jurisdiction and was completed on (mo/day/year) 03-05-91 and this record is true to the best of my knowledge and belief. Kansas Water Well Contractor's License No. 479 This Water Well Record was completed on (mo/day/yr) 03-07-91 under the business name of EBBERTS DRILLING by (signature) Arrogan Street