


LOCATION OF WATER WELL: County: Lyon Fraction: SW 1/4 NE 1/4 SE Section Number: 33 Township Number: T 20 S Range Number: R 10 E

Distance and direction from nearest town or city street address of well if located within city?
7 West 1/2 North Olpe

WATER WELL OWNER: Jerry Conrade
 RR#, St. Address, Box #: RR Olpe ks 66865
 City, State, ZIP Code: Olpe ks 66865
 Board of Agriculture, Division of Water Resources
 Application Number: NA

LOCATE WELL'S LOCATION WITH AN "X" IN SECTION BOX:

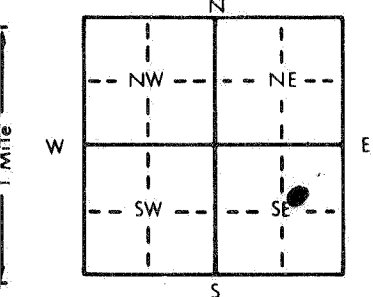

DEPTH OF COMPLETED WELL: 57 ft. ELEVATION: _____ ft.

Depth(s) Groundwater Encountered 1. 35-38 ft. 2. _____ ft. 3. _____ ft.

WELL'S STATIC WATER LEVEL: 20 ft. below land surface measured on 6-23-86 mo/day/yr

Pump test data: Well water was _____ ft. after _____ hours pumping _____ gpm

Est. Yield: 4 gpm; Well water was _____ ft. after _____ hours pumping _____ gpm

Bore Hole Diameter: 12 in. to 57 ft., and _____ in. to _____ ft.

WELL WATER TO BE USED AS: Domestic Feedlot Oil field water supply Dewatering Injection well

Irrigation Industrial Lawn and garden only Observation well

Was a chemical/bacteriological sample submitted to Department? Yes _____ No If yes, mo/day/yr sample was submitted

Water Well Disinfected? Yes No _____

TYPE OF BLANK CASING USED: Steel RMP (SR) Asbestos-Cement Other (specify below) PVC ABS Fiberglass

CASING JOINTS: Glued Clamped _____ Welded _____ Threaded _____

Blank casing diameter: 8 in. to 20 ft., Dia _____ in. to _____ ft., Dia _____ in. to _____ ft.

Casing height above land surface: 24 in., weight _____ lbs./ft. Wall thickness or gauge No. 160

TYPE OF SCREEN OR PERFORATION MATERIAL: Steel Stainless steel Fiberglass RMP (SR) Asbestos-cement

Brass Galvanized steel Concrete tile ABS Other (specify) _____

SCREEN OR PERFORATION OPENINGS ARE: Continuous slot Mill slot Gauzed wrapped Saw cut None (open hole)

Louvered shutter Key punched Wire wrapped Drilled holes Other (specify) _____

SCREEN-PERFORATED INTERVALS: From 24 ft. to 50 ft., From _____ ft. to _____ ft.

GRAVEL PACK INTERVALS: From _____ ft. to _____ ft., From _____ ft. to _____ ft.

GRAVEL PACK INTERVALS: From _____ ft. to _____ ft., From _____ ft. to _____ ft.

GROUT MATERIAL: Neat cement Cement grout Bentonite Other _____

Grout Intervals: From _____ ft. to _____ ft., From _____ ft. to _____ ft., From _____ ft. to _____ ft.

What is the nearest source of possible contamination: Septic tank Lateral lines Pit privy Livestock pens Abandoned water well

Sewer lines Cess pool Sewage lagoon Fuel storage Oil well/Gas well

Watertight sewer lines Seepage pit Feedyard Fertilizer storage Other (specify below)

Direction from well? South Down Grade Insecticide storage Other (specify below)

How many feet? 170'

FROM	TO	LITHOLOGIC LOG	FROM	TO	LITHOLOGIC LOG
		<u>Pulled old Tim Casing. Ream Hole to 57'</u>			
		<u>No Samples</u>			

CONTRACTOR'S OR LANDOWNER'S CERTIFICATION: This water well was (1) constructed, (2) reconstructed, or (3) plugged under my jurisdiction and was completed on (mo/day/year) 6-1-86 and this record is true to the best of my knowledge and belief. Kansas

Water Well Contractor's License No. _____ This Water Well Record was completed on (mo/day/yr) 6-23-86

under the business name of McNee Drilling & Metals by (signature) J. McNee

INSTRUCTIONS: Use typewriter or ball point pen, PLEASE PRESS FIRMLY and PRINT clearly. Please fill in blanks, underline or circle the correct answers. Send top three copies to Kansas Department of Health and Environment, Division of Environment, Environmental Geology Section, Topeka, KS 66620. Send one to WATER WELL OWNER and retain one for your records.