

County: Lyon Fraction: SE, SE, NE, SE Sec. 30 T. 20 S. R. 11 E

**CORRECTION(S) to WATER WELL COMPLETION RECORD Form WWC-5 (to rectify lacking or incorrect information)**

Owner: Jerry & Beverly Crook	Hand-Dug Well
If location corrected, was listed as:	Location changed to:
Section-Township-Range:	
Fraction (1/4 calls): NE, SE	SE, SE, NE, SE
Other changes: Initial statements: Not reported - casing type, diameter, & whether any was removed.	
Changed to: Rock casing, 48-in inside & 72-in outside diameter, removed rock casing to 5-ft below land surface.	
Comments:	
Verification method: STR Finder & Lyon Co. Conservation District Well Decommissioning Form - 351 (attached to well plugging record)	
Submitted by: <input type="checkbox"/> Kansas Geological Survey, Data Resources Library, 1930 Constant Ave., Lawrence, KS 66047-3724 <input checked="" type="checkbox"/> Kansas Dept. of Health & Environment, Bureau of Water, 1000 SW Jackson, Suite 420, Topeka, KS 66612-1367	
Initials: PKC Date: 8/29/2025	

(rev 01/26/2018)

## WATER WELL PLUGGING RECORD

Form WWC-5P

KSA 82a-1212

ID NO. \_\_\_\_\_

1 LOCATION OF WATER WELL:		Fraction County: <i>Lyon</i> <i>NE 1/4 SE 1/4 1/4 1/4</i>	Section Number 30	Township Number T 20 S	Range Number 11 <input checked="" type="checkbox"/> E <input type="checkbox"/>	
Street/Rural Address of Well Location; if unknown, distance & direction from nearest town or intersection: If at owner's address, check here <input checked="" type="checkbox"/>			Global Positioning Systems (GPS) information: Latitude: <i>N 38 16,726</i> (in decimal degrees) Longitude: <i>W 096 13,615</i> (in decimal degrees) Elevation: <i>1190'</i> Horizontal Datum: <input checked="" type="checkbox"/> WGS84, <input type="checkbox"/> NAD83, <input type="checkbox"/> NAD Collection Method:	
2 WATER WELL OWNER:		<i>Jerry &amp; Beverly Creek RR# 1, St. Address, Box #: 831 Rd H City, State ZIP Code: Olpe, KS 66865</i>		<input checked="" type="checkbox"/> GPS unit (Make/Model: <i>Garmin GP576</i> ) <input type="checkbox"/> Digital Map/Photo, <input type="checkbox"/> Topographic Map, <input type="checkbox"/> Land Survey Est. Accuracy: <input type="checkbox"/> < 3 m, <input type="checkbox"/> 3-5 m, <input checked="" type="checkbox"/> 5-15 m, <input type="checkbox"/> > 15 m	
3 MARK WELL'S LOCATION WITH AN "X" IN SECTION BOX:		4 DEPTH OF WELL <u>15</u> ft. WELL'S STATIC WATER LEVEL <u>11</u> ft. WELL WAS USED AS: <table> <tr> <td><input checked="" type="checkbox"/> Domestic</td> <td><input type="checkbox"/> Public Water Supply</td> <td><input type="checkbox"/> Dewatering</td> </tr> <tr> <td><input type="checkbox"/> Irrigation</td> <td><input type="checkbox"/> Oil Field Water Supply</td> <td><input type="checkbox"/> Monitoring</td> </tr> <tr> <td><input type="checkbox"/> Feedlot</td> <td><input type="checkbox"/> Domestic (Lawn &amp; Garden)</td> <td><input type="checkbox"/> Injection Well</td> </tr> <tr> <td><input type="checkbox"/> Industrial</td> <td><input type="checkbox"/> Air Conditioning</td> <td><input type="checkbox"/> Other _____</td> </tr> </table> Was a chemical/bacteriological sample submitted to Department? Yes <input type="checkbox"/> No <input checked="" type="checkbox"/>				<input checked="" type="checkbox"/> Domestic	<input type="checkbox"/> Public Water Supply	<input type="checkbox"/> Dewatering	<input type="checkbox"/> Irrigation	<input type="checkbox"/> Oil Field Water Supply	<input type="checkbox"/> Monitoring	<input type="checkbox"/> Feedlot	<input type="checkbox"/> Domestic (Lawn & Garden)	<input type="checkbox"/> Injection Well	<input type="checkbox"/> Industrial	<input type="checkbox"/> Air Conditioning	<input type="checkbox"/> Other _____	
<input checked="" type="checkbox"/> Domestic	<input type="checkbox"/> Public Water Supply	<input type="checkbox"/> Dewatering	
<input type="checkbox"/> Irrigation	<input type="checkbox"/> Oil Field Water Supply	<input type="checkbox"/> Monitoring	
<input type="checkbox"/> Feedlot	<input type="checkbox"/> Domestic (Lawn & Garden)	<input type="checkbox"/> Injection Well	
<input type="checkbox"/> Industrial	<input type="checkbox"/> Air Conditioning	<input type="checkbox"/> Other _____	
5 TYPE OF BLANK CASING USED:	
<input type="checkbox"/> Steel <input type="checkbox"/> RMP (SR) <input type="checkbox"/> Wrought <input type="checkbox"/> Fiberglass <input type="checkbox"/> PVC <input type="checkbox"/> ABS <input type="checkbox"/> Asbestos-Cement <input type="checkbox"/> Concrete Tile <input type="checkbox"/> Other (Specify below) _____	
Blank casing diameter _____ in.   Was casing pulled? Yes <input type="checkbox"/> No <input type="checkbox"/> If yes, how much _____ Casing height above or below land surface _____ in.	
6 GROUT PLUG MATERIAL:	
<input type="checkbox"/> Neat cement <input type="checkbox"/> Cement grout <input checked="" type="checkbox"/> Bentonite <input type="checkbox"/> Other _____	
Grout Plug Intervals: From <u>5</u> ft. to <u>4.5</u> ft., From _____ ft. to _____ ft., From _____ ft. to _____ ft.	
What is the nearest source of possible contamination: <table> <tr> <td><input type="checkbox"/> Septic tank</td> <td><input type="checkbox"/> Seepage pit</td> <td><input type="checkbox"/> Fuel storage</td> <td><input checked="" type="checkbox"/> Other (specify below) _____</td> </tr> <tr> <td><input type="checkbox"/> Sewer lines</td> <td><input type="checkbox"/> Pit privy</td> <td><input type="checkbox"/> Fertilizer storage</td> <td><input type="checkbox"/> pond</td> </tr> <tr> <td><input type="checkbox"/> Watertight sewer lines</td> <td><input type="checkbox"/> Sewage lagoon</td> <td><input type="checkbox"/> Insecticide storage</td> <td><input type="checkbox"/> SW</td> </tr> <tr> <td><input type="checkbox"/> Lateral lines</td> <td><input type="checkbox"/> Feedyard</td> <td><input type="checkbox"/> Abandoned water well</td> <td><input type="checkbox"/> How many feet? <u>20'</u></td> </tr> <tr> <td><input type="checkbox"/> Cess pool</td> <td><input type="checkbox"/> Livestock pens</td> <td><input type="checkbox"/> Oil well/Gas well</td> <td></td> </tr> </table>						<input type="checkbox"/> Septic tank	<input type="checkbox"/> Seepage pit	<input type="checkbox"/> Fuel storage	<input checked="" type="checkbox"/> Other (specify below) _____	<input type="checkbox"/> Sewer lines	<input type="checkbox"/> Pit privy	<input type="checkbox"/> Fertilizer storage	<input type="checkbox"/> pond	<input type="checkbox"/> Watertight sewer lines	<input type="checkbox"/> Sewage lagoon	<input type="checkbox"/> Insecticide storage	<input type="checkbox"/> SW	<input type="checkbox"/> Lateral lines	<input type="checkbox"/> Feedyard	<input type="checkbox"/> Abandoned water well	<input type="checkbox"/> How many feet? <u>20'</u>	<input type="checkbox"/> Cess pool	<input type="checkbox"/> Livestock pens	<input type="checkbox"/> Oil well/Gas well																																			
<input type="checkbox"/> Septic tank	<input type="checkbox"/> Seepage pit	<input type="checkbox"/> Fuel storage	<input checked="" type="checkbox"/> Other (specify below) _____	
<input type="checkbox"/> Sewer lines	<input type="checkbox"/> Pit privy	<input type="checkbox"/> Fertilizer storage	<input type="checkbox"/> pond	
<input type="checkbox"/> Watertight sewer lines	<input type="checkbox"/> Sewage lagoon	<input type="checkbox"/> Insecticide storage	<input type="checkbox"/> SW	
<input type="checkbox"/> Lateral lines	<input type="checkbox"/> Feedyard	<input type="checkbox"/> Abandoned water well	<input type="checkbox"/> How many feet? <u>20'</u>	
<input type="checkbox"/> Cess pool	<input type="checkbox"/> Livestock pens	<input type="checkbox"/> Oil well/Gas well	
<table border="1"> <thead> <tr> <th>FROM</th> <th>TO</th> <th>PLUGGING MATERIALS</th> <th>FROM</th> <th>TO</th> <th>PLUGGING MATERIALS</th> </tr> </thead> <tbody> <tr> <td><u>15'</u></td> <td><u>11'</u></td> <td><u>4 ton sand 1.5 gal</u></td> <td></td> <td></td> <td></td> </tr> <tr> <td><u>11'</u></td> <td><u>5'</u></td> <td><u>side wall stone / clay dirt</u></td> <td></td> <td></td> <td></td> </tr> <tr> <td><u>5'</u></td> <td><u>4.5</u></td> <td><u>19 50# bags bentonite</u></td> <td></td> <td></td> <td></td> </tr> <tr> <td><u>4.5'</u></td> <td><u>0'</u></td> <td><u>clay / black dirt</u></td> <td></td> <td></td> <td></td> </tr> <tr> <td></td> <td></td> <td></td> <td></td> <td></td> <td></td> </tr> </tbody> </table>						FROM	TO	PLUGGING MATERIALS	FROM	TO	PLUGGING MATERIALS	<u>15'</u>	<u>11'</u>	<u>4 ton sand 1.5 gal</u>				<u>11'</u>	<u>5'</u>	<u>side wall stone / clay dirt</u>				<u>5'</u>	<u>4.5</u>	<u>19 50# bags bentonite</u>				<u>4.5'</u>	<u>0'</u>	<u>clay / black dirt</u>																											
FROM	TO	PLUGGING MATERIALS	FROM	TO	PLUGGING MATERIALS	
<u>15'</u>	<u>11'</u>	<u>4 ton sand 1.5 gal</u>	
<u>11'</u>	<u>5'</u>	<u>side wall stone / clay dirt</u>	
<u>5'</u>	<u>4.5</u>	<u>19 50# bags bentonite</u>	
<u>4.5'</u>	<u>0'</u>	<u>clay / black dirt</u>	
7 CONTRACTOR'S OR LANDOWNER'S CERTIFICATION: This water well was plugged under my jurisdiction and was completed on (mo/day/year) <u>10/12/23</u> and this record is true to the best of my knowledge and belief. Kansas Water Well Contractor's License No. _____ This Water Well Record was completed on (mo/day/year) <u>10/12/23</u> under the business name of <u>O'Neal Const. LLC</u> by (signature) <u>John H. O'Neal</u>	
Send one white copy to Kansas Department of Health & Environment, Geology Section, 1000 SW Jackson Street, Ste. 420, Topeka, KS 66612-1367. Send one copy to WATER WELL OWNER and retain one for your records. Visit us at <a href="http://www.kdheks.gov/waterwell/index.html">http://www.kdheks.gov/waterwell/index.html</a> Telephone 785-296-5524.	

USDA  
NRCS

**WELL DECOMMISSIONING - 351**  
Well Plugging Worksheet for an Unconfined Aquifer

KS  
8.19

NAME: Jerry & Beverly Crook  
LEGAL: 30-20-11  
COUNTY: Lyon

Design By: Anna Rommc  
Check By: CGJones

Date: 9/15/2023  
Date: 9/29/2023

IDENT #:

Type of Well:  Drilled  Hand Dug

Diameter (inside inches): 48 Dia. (outside inches): 72 Depth to water: 11.0 ft. Total depth: 15.0 ft.

From 4.5 feet below the ground surface to the ground surface, the plugged well shall be covered with compacted silt, clay soils, or surface soils.

**PLUG**

Place a minimum 0.5-foot thick plug using approved cement or bentonite grout, to the full well diameter after removal of rock lining.

**SUBSOIL**


From the static water level to 5 feet below the ground surface, the well shall be filled with compacted clay or an approved grout.

Static Water Level

Household chlorine bleach at 5.25 percent concentration of chlorine can be used in a ratio of 1 gallon bleach per 500 gallons of water.

**SAND**

Fill the well with clean sand or gravel up to the Static Water Level.

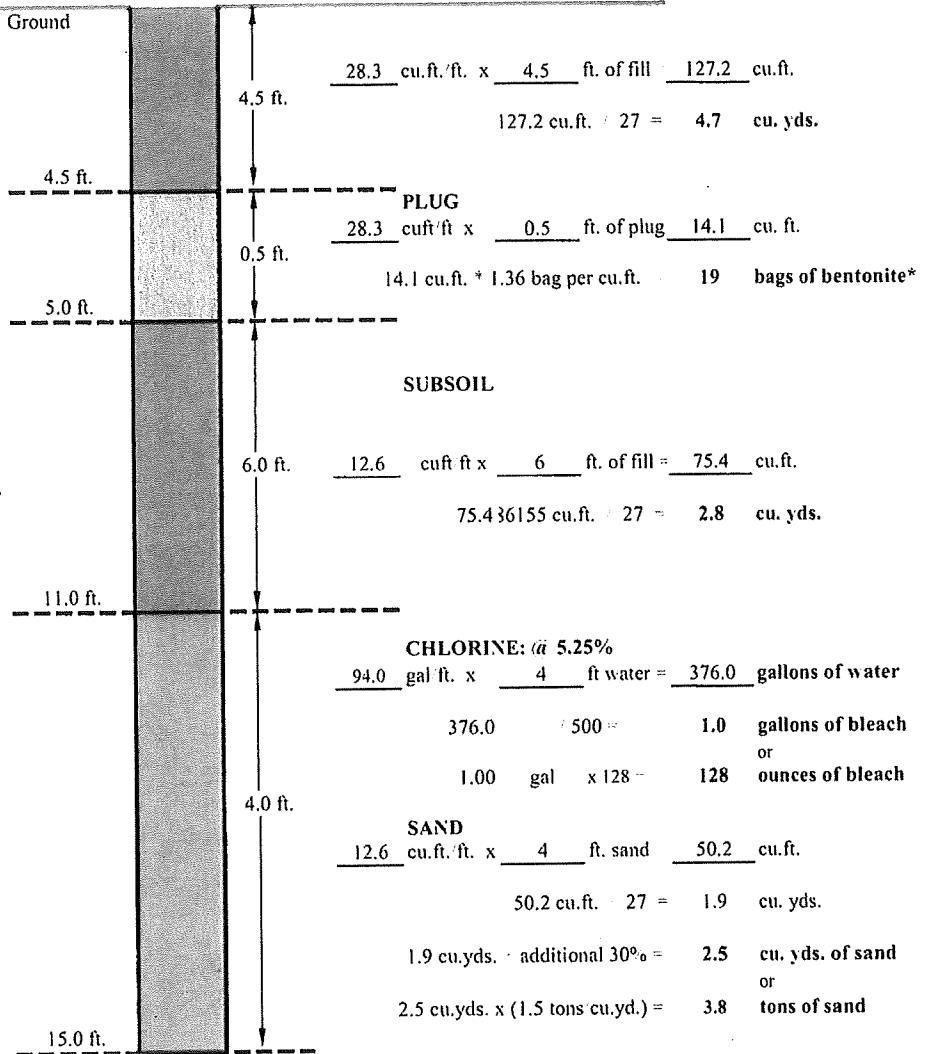

Remove pump, column pipe, and debris. Knock down the top 5 feet of the well rock lining material and let it fall into the well. Prior to starting work, stockpile fill material on site, leaving fill material on a truck or trailer until placed if possible.

\* Based on a 50 lb bag of bentonite chips with a unit weight of 68 lb/cf.

## Well Decommissioning – 351

Table of Quantities

	Item	Unit	Planned or Designed Quantity	Installed Quantity
Total Well Depth	lin. ft.	150		
Diameter Plugged	inches	48		
Well Section 1: Top	From	feet	0.0	
	To	feet	4.5	
Fill Material (Soil)	cu. ft.	127.2		
Well Section 2: Well Plug	From	feet	4.5	
	To	feet	5.0	
KDHE Approved Bentonite or Cement Grout	cu. ft.	14.1		
Well Section 3: Subsoil	From	feet	5.0	
	To	feet	11.0	
Fill Material: Native Clay Soils	cu. ft.	75.4		
Well Section 4: Fill Below the Static Waterline	From	feet	11.0	
	To	feet	15.0	
Fill Material (Sand or Gravel)	tons	3.8		
Household Bleach Disinfectant (5 25% solution)	gallons	1.0		

## Note:

Railroad ties permanently placed over well with a decorative fixture over the top of the railroad ties. I spoke with Jerry and Beverly Crook and they gave me the history of the well and what they believed to be the depth now, as they filled it with topsoil many years ago. Carl Jarboe and I measured between the railroad ties to find the rock casing width, well depth, and depth to water. These measurements aligned with what the landowner believed to be the depth and width of the well.



## Location Map

Scale 1"

Not to scale

Designed by	Anna Romme	Date	9/15/2023
Checked by	C. Jones <b>CHARLES</b>	Date	9/29/2023
Approved by	Charles Jones <b>JONES</b>	Date	2023-09-29 PRB21 0900
I certify that this installed practice meets NRCS standards and specifications and conforms to the approved drawings			
Checked out by		Date	
Audited by		Date	

WELL PLUGGING RECORD In accordance with Kansas Administrative Regulations (K.A.R.) 28-30-201, file a record of the well plugging with the Kansas Department of Health and Environment (KDHE) office in Topeka, Kansas within 30 days following the completion of the plugging. Use either form WPL-5 or WPL-5P to record this information.