

CORRECTION(S) TO WATER WELL RECORD (WWC-5)

(to rectify lacking or incorrect information)

County: Lyon

Location listed as:

Location changed to:

Section-Township-Range:

25-20-1225-20S-12EFraction ($\frac{1}{4}$ $\frac{1}{4}$ $\frac{1}{4}$):SWS2 SW

Other changes: Initial statements:

Changed to:


Comments:

verification method: Legal description, well owner's address, position on plat map, and county ownership map.initials: ORL date: 7/13/2005submitted by: Kansas Geological Survey, Data Resources Library, 1930 Constant Ave., Lawrence, KS 66047-3726
to: Kansas Dept of Health & Environment, Bureau of Water, 1000 SW Jackson, Suite 420, Topeka, KS 66612-1367.

1 LOCATION OF WATER WELL: Fraction Section Number Township Number Range Number
 County: LYON SW₄ $\frac{1}{4}$ $\frac{1}{4}$ 25 20 12

Distance and direction from nearest town or city street address of well if located within city?

2 WATER WELL OWNER: Darbyshire Farms LLC
 RR #, St. Address, Box #: 805 Rd X 5 Hartford KS 66854 Board of Agriculture, Division of Water Resources
 City, State, ZIP Code : Application Number:

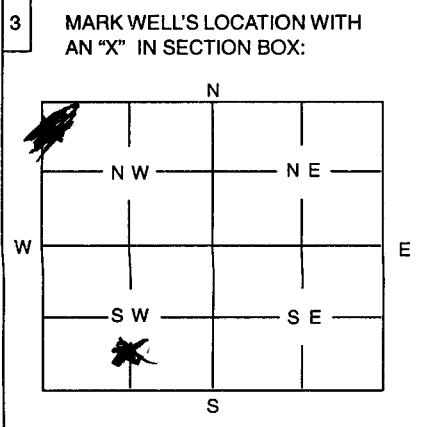

4 DEPTH OF WELL 23 ft
 WELL'S STATIC WATER LEVEL 4 ft
 WELL WAS USED AS:
 Domestic 5 Public Water Supply 9 Dewatering
 Irrigation 6 Oil Field Water Supply 10 Monitoring Well
 Feedlot 7 Domestic (Lawn & Garden) 11 Injection Well
 Industrial 8 Air Conditioning 12 Other

Was a chemical / bacteriological sample submitted to Department? Yes No X
 If yes, mo/day/yr sample was submitted

Water Well Disinfected: Yes X No

5 TYPE OF BLANK CASING USED:
 1 Steel 3 RMP (SR) 5 Wrought 7 Fiberglass Other (Specify below) Rock
 2 PVC 4 ABS 6 Asbestos-Cement 8 Concrete Tile

Blank casing diameter 4.8 in. Was casing pulled? Yes X No If yes, how much 5 ft.
 Casing height above or below land surface 60 in.

6 GROUT PLUG MATERIAL: 1 Neat cement 2 Cement grout 3 Bentonite 4 Other

Grout Plug Intervals: From 5 ft. to 4 1/2 ft., From ft. to ft., From to ft.

What is the nearest source of possible contamination:
 1 Septic tank 6 Seepage pit 11 Fuel storage 16 Other (specify below) Farm AMD
 2 Sewer lines 7 Pit privy 12 Fertilizer storage
 3 Watertight sewer lines 8 Sewage lagoon 13 Insecticide storage
 4 Lateral lines 9 Feedyard 14 Abandoned water well
 5 Cess Pool 10 Livestock pens 15 Oil well/Gas well

Direction from well? all around How many feet? 0

FROM	TO	PLUGGING MATERIALS
23	19	Gravel
19	5	Subsoil
5	4.5	Bentonite
4.5	0	TOP SOIL

well is located in a farmed field.

7 CONTRACTOR'S OR LANDOWNER'S CERTIFICATION: This water well was plugged under my jurisdiction and was completed on (mo/day/year) X 05-24-05 and this record is true to the best of my knowledge and belief. Kansas Water Well Contractor's License No. This Water Well Record was completed on (mo/day/year) under the business name of by (signature) X Darbyshire

INSTRUCTIONS: Use typewriter or ball point pen. Please press firmly and print clearly. Please fill in blanks, underline or circle the correct answers. Send top three copies to Kansas Department of Health and Environment, Bureau of Water, Topeka, Kansas 66620-0001. Telephone: 785/296-3565. Send one to Water Well Owner and retain one for your records.