


1 LOCATION OF WATER WELL: Fraction SW 1/4 SW 1/4 NE 1/4 Section Number 33 Township Number T 20 S Range Number R 13 E/W
 County: LYON

Distance and direction from nearest town or city street address of well if located within city?

2 MS - 1 W of HARTFORD KS

2 WATER WELL OWNER: PETER N. DR JAN L. DAVIS LAND OWNER - A.W. LILLIAN
 RR#, St. Address, Box #: 205 W PLUMB Board of Agriculture, Division of Water Resources
 City, State, ZIP Code: HARTFORD KS 66854 Application Number:

3 LOCATE WELL'S LOCATION WITH AN "X" IN SECTION BOX:

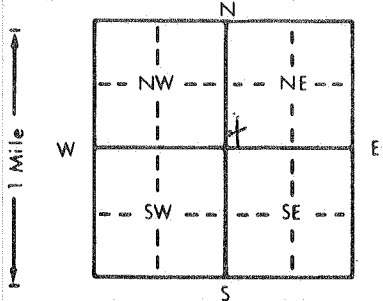

4 DEPTH OF COMPLETED WELL: 33.5 ft. ELEVATION:

Depth(s) Groundwater Encountered 1 26-33.5 ft. 2 27.5 ft. 3 _____ ft.

WELL'S STATIC WATER LEVEL 21 ft. below land surface measured on mo/day/yr 05-24-90

Pump test data: Well water was _____ ft. after _____ hours pumping _____ gpm

Est. Yield 6 gpm: Well water was _____ ft. after _____ hours pumping _____ gpm

Bore Hole Diameter 5 in. to 33.5 ft. and _____ in. to _____ ft.

WELL WATER TO BE USED AS: 5 Public water supply 8 Air conditioning 11 Injection well

1 Domestic 3 Feedlot 6 Oil field water supply 9 Dewatering 12 Other (Specify below)

2 Irrigation 4 Industrial 7 Lawn and garden only 10 Monitoring well WATER TEST

Was a chemical/bacteriological sample submitted to Department? Yes _____ No X If yes, mo/day/yr sample was submitted BY OTHERS - ATTACHED Water Well Disinfected? Yes X No _____

5 TYPE OF BLANK CASING USED: NA 5 Wrought iron 8 Concrete tile CASING JOINTS: Glued _____ Clamped _____

1 Steel 3 RMP (SR) 6 Asbestos-Cement 9 Other (specify below) Welded _____

2 PVC 4 ABS 7 Fiberglass _____ Threaded _____

Blank casing diameter _____ in. to _____ ft., Dia _____ in. to _____ ft., Dia _____ in. to _____ ft.

Casing height above land surface _____ in., weight _____ lbs./ft. Wall thickness or gauge No. _____

TYPE OF SCREEN OR PERFORATION MATERIAL: NA 7 PVC 10 Asbestos-cement

1 Steel 3 Stainless steel 5 Fiberglass 8 RMP (SR) 11 Other (specify) _____

2 Brass 4 Galvanized steel 6 Concrete tile 9 ABS 12 None used (open hole)

SCREEN OR PERFORATION OPENINGS ARE: NA 5 Gauzed wrapped 8 Saw cut 11 None (open hole)

1 Continuous slot 3 Mill slot 6 Wire wrapped 9 Drilled holes

2 Louvered shutter 4 Key punched 7 Torch cut 10 Other (specify) _____

SCREEN-PERFORATED INTERVALS: NA From _____ ft. to _____ ft., From _____ ft. to _____ ft.

GRAVEL PACK INTERVALS: From _____ ft. to _____ ft., From _____ ft. to _____ ft.

From _____ ft. to _____ ft., From _____ ft. to _____ ft.

6 GROUT MATERIAL: 1 Neat cement 2 Cement grout 3 Bentonite 4 Other _____

Grout Intervals: From GL ft. to 13 ft., From _____ ft. to _____ ft., From _____ ft. to _____ ft.

What is the nearest source of possible contamination: 10 Livestock pens 14 Abandoned water well

1 Septic tank 4 Lateral lines 7 Pit privy 11 Fuel storage 15 Oil well/Gas well

2 Sewer lines 5 Cess pool 8 Sewage lagoon 12 Fertilizer storage 16 Other (specify below)

3 Watertight sewer lines 6 Seepage pit 9 Feedyard 13 Insecticide storage

Direction from well? How many feet?

FROM	TO	LITHOLOGIC LOG	FROM	TO	PLUGGING INTERVALS
0	2	TOP SOIL			NOTE: SAND + WELL COLLINGS WERE USED FOR MULL UP FOR REPLACEMENT OF LOWER CAUSE IN - PUMP TEST AT 15 GPM FOR 12-15 MIN. HOLE CAVED IN ON PUMPS. BAILER TEST WHILE DRILLING = 6-8 GPM
2	17	CLAY FIRM			
17	26	CLAY - SDY - VERY SOFT			
26	27.5	SDY - GRAVEL - SILT - CLAY			
27.5	33.5	LIME			

7 CONTRACTOR'S OR LANDOWNER'S CERTIFICATION: This water well was (1) constructed, (2) reconstructed, or (3) plugged under my jurisdiction and was completed on (mo/day/year) 05-24-90 and this record is true to the best of my knowledge and belief. Kansas Water Well Contractor's License No. 479 This Water Well Record was completed on (mo/day/yr) 05-28-90 under the business name of EBBERTS DRILLING by (signature) Gregory Ebberts