


1 LOCATION OF WATER WELL: Fraction NE 1/4 SW 1/4 SW 1/4 Section Number 25 Township Number T 20 S Range Number R 14 E/W  
 County: COFFEY

Distance and direction from nearest town or city street address of well if located within city?  
FROM HARTFORD - 3S - 3 1/2 E - 1/2 N - 1/2 E - 1/2 N - 1/4 W - 1/4 N

2 WATER WELL OWNER: PHILLIP HAIGHT - HAIGHT PROPERTIES, INC.  
 RR#, St. Address, Box #: 1801 CENTURY PARK EAST Board of Agriculture, Division of Water Resources  
 City, State, ZIP Code: LDS ANGELES CALIFORNIA 90067 Application Number: -

3 LOCATE WELL'S LOCATION WITH AN "X" IN SECTION BOX:

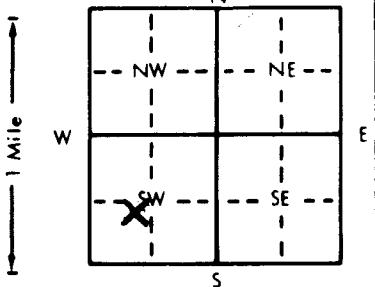

4 DEPTH OF COMPLETED WELL: 96 ft. ELEVATION: -  
 Depth(s) Groundwater Encountered 1. 91 ft. 2. - ft. 3. - ft.  
 WELL'S STATIC WATER LEVEL: 86 ft. below land surface measured on mo/day/yr 01-23-91  
 Pump test data: Well water was - ft. after - hours pumping - gpm  
 Est. yield SEAP gpm: Well water was - ft. after - hours pumping - gpm  
 Bore Hole Diameter: 8 7/8 in. to 96 ft. and - in. to - ft.  
 WELL WATER TO BE USED AS:  
 5 Public water supply 8 Air conditioning 11 Injection well  
 1 Domestic 3 Feedlot 6 Oil field water supply 9 Dewatering 12 Other (Specify below)  
 2 Irrigation 4 Industrial 7 Lawn and garden only 10 Monitoring well  
 Was a chemical/bacteriological sample submitted to Department? Yes - No X; If yes, mo/day/yr sample was submitted -  
 Water Well Disinfected? Yes X No -

5 TYPE OF BLANK CASING USED: NA  
 1 Steel 3 RMP (SR) 5 Wrought iron 8 Concrete tile CASING JOINTS: Glued - Clamped -  
 2 PVC 4 ABS 6 Asbestos-Cement 9 Other (specify below) Welded -  
 7 Fiberglass Threaded -  
 Blank casing diameter NA in. to - ft. Dia. - in. to - ft. Dia. - in. to - ft.  
 Casing height above land surface NA in., weight - lbs./ft. Wall thickness or gauge No. -

TYPE OF SCREEN OR PERFORATION MATERIAL: NA  
 1 Steel 3 Stainless steel 5 Fiberglass 8 RMP (SR) 10 Asbestos-cement  
 2 Brass 4 Galvanized steel 6 Concrete tile 9 ABS 11 Other (specify) -  
 12 None used (open hole)  
 SCREEN OR PERFORATION OPENINGS ARE: NA  
 1 Continuous slot 3 Mill slot 5 Gauzed wrapped 8 Saw cut 11 None (open hole)  
 2 Louvered shutter 4 Key punched 6 Wire wrapped 9 Drilled holes  
 7 Torch cut 10 Other (specify) -

SCREEN-PERFORATED INTERVALS: From NA ft. to - ft., From - ft. to - ft., From - ft. to - ft.  
 GRAVEL PACK INTERVALS: From NA ft. to - ft., From - ft. to - ft., From - ft. to - ft.

6 GROUT MATERIAL: 1 Neat cement 2 Cement grout 3 Bentonite 4 Other DRILL CUTTINGS - CLAY ETC.  
 Grout Intervals: From 2 ft. to 13 ft., From 13 ft. to 96 ft., From - ft. to - ft.  
 What is the nearest source of possible contamination:  
 1 Septic tank 4 Lateral lines 7 Pit privy 10 Livestock pens 14 Abandoned water well  
 2 Sewer lines 5 Cess pool 8 Sewage lagoon 11 Fuel storage 15 Oil well/Gas well  
 3 Watertight sewer lines 6 Seepage pit 9 Feedyard 12 Fertilizer storage 16 Other (specify below) -  
 13 Insecticide storage -  
 Direction from well? - How many feet? -

FROM	TO	LITHOLOGIC LOG	FROM	TO	PLUGGING INTERVALS
0	12	CLAY			
12	23	LIME TOP 3' VERY HARD			* WATER TASTE TEST
23	24.5	SHALE VERY DARK			
24.5	26.5	COAL			BITTER - VERY BITTER!
26.5	28.5	LIME			
28.5	39	SHALE GREY			SUG. ANY WELL DRILLED TO THIS FORMATION THAT HAS AMPLE FLOW SHOULD BE TESTED BEFORE COMPLETION (WITH IN THIS AREA OF COFFEY CO)
39	43	LIME			
43	64	SHALE LT. GREY			
64	68	SDY-LIME+SHALE LAYERS			
68	80	SHALE LT. GREY			
80	85	LIME LAYERS-SHALE			
85	87	SHALE DK GREY			
87	91	LAYERS-LIME+SHALE VERY DK			
91	93	LIME TAN + VERY HARD			
93	96	LIME LT GREY -TD			

7 CONTRACTOR'S OR LANDOWNER'S CERTIFICATION: This water well was (1) constructed, (2) reconstructed, or (3) plugged under my jurisdiction and was completed on (mo/day/year) 01-23-91 and this record is true to the best of my knowledge and belief. Kansas Water Well Contractor's License No. 479 This Water Well Record was completed on (mo/day/yr) 01-23-91 under the business name of ERBERTS DRILLING by (signature) Erbert