USE TYPEWRITER OR BALL POINT PEN-PRESS FIRMLY, PRINT CLEARLY.

WATER WELL RECORD
KSA 82a-1201-1215

Kansas Department of Health and Environment-Division of Environment
(Water well Contractors)
Topeka, Kansas 66620

1. Location of well:	County: Coffey	Fraction: NE 1/4 NE 1/4 1/4	Section number: 27	Township number: T 20 S	Range number: R 14 E W

2. Distance and direction from nearest town or city: ½ Mile N New Stream 6½ Miles West
Street address of well location if in city:

3. Owner of well: Joe A Vaughn
R.R. or street: RI
City, state, zip code: Americus, Kans 66835

4. Locate with "X" in section below:

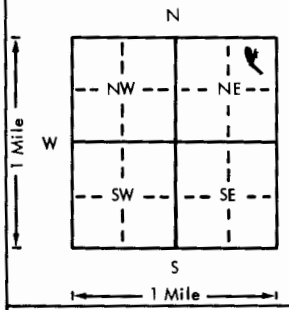

Sketch map:

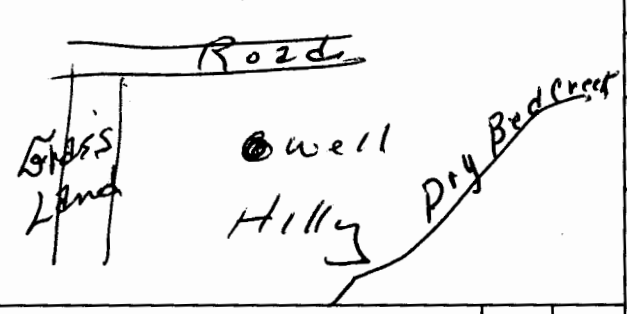

6. Bore hole dia. 8¾ in. Completion date 8/24/78
Well depth 112 ft.

7. X Cable tool __ Rotary __ Driven __ Dug
__ Hollow rod __ Jetted __ Bored __ Reverse rotary

8. Use: X Domestic __ Public supply __ Industry
__ Irrigation __ Air conditioning __ Stock
__ Lawn __ Oil field water __ Other

9. Casing: Material ____ Height: Above or below
Threaded ____ Welded ____ Surface ____ in.
RMP ____ PVC ____ Weight ____ lbs./ft.
Dia. ____ in. to ____ ft. depth Wall Thickness: inches or
Dia. ____ in. to ____ ft. depth gage No. ____

None

5. Type and color of material	From	To
Soil	0	2
Clay Yellow	2	6
Lime Hard	6	12
Shale Blue	12	27
Lime Hard	27	32
Shale Blue	32	38
Lime Hard	38	41
Shale Blue	41	52
Lime Hard	52	57
Shale Gray	57	58
Lime Hard	58	59
Shale Blue	59	65
Sandy Shale	65	67
Shale Gray	67	97
Lime Hard	97	100
(Use a second sheet if needed) Shale Blue	100	112

10. Screen: Manufacturer's name ____
Type ____ Dia. ____
Slot/gauze ____ Length ____
Set between ____ ft. and ____ ft.
____ ft. and ____ ft.
Gravel pack? ____ Size range of material ____

None

11. Static water level: ____ ft. below land surface Date ____ mo./day/yr.

12. Pumping level below land surfaces:
____ ft. after ____ hrs. pumping ____ g.p.m.
____ ft. after ____ hrs. pumping ____ g.p.m.
Estimated maximum yield ____ g.p.m.

None

13. Water sample submitted: mo./day/yr.
____ Yes ____ No Date ____

None

14. Well head completion:
____ Pitless adapter ____ Inches above grade

15. Well grouted? ____
With: X Neat cement ____ Bentonite ____ Concrete
Depth: From 0 ft. to 10 ft.

16. Nearest source of possible contamination:
ft. ____ Direction ____ Type ____
Well disinfected upon completion? ____ Yes ____ No

None

17. Pump: X Not installed
Manufacturer's name ____
Model number ____ HP ____ Volts ____
Length of drop pipe ____ ft. capacity ____ g.p.m.
Type:
____ Submersible ____ Turbine
____ Jet ____ Reciprocating
____ Centrifugal ____ Other

18. Elevation:

Topography:
____ Hill
X Slope
____ Upland
____ Valley

19. Remarks: Hole Dry — Fill Hole with Cuttings from Well Cemented Top 10'

20. Water well contractor's certification:
This well was drilled under my jurisdiction and this report is true to the best of my knowledge and belief.
Eureka Well Service 296
Business name License No.
Address 225 S Walnut Eureka, Kans
Signed True Ashlock Jr. Date 18-28
Authorized representative

T 20 S R 14 E W Sec 27 1/4 NE 1/4 NE 1/4

Forward the white, blue and pink copies to the Department of Health and Environment

Form WWC-5

MI-1023